


Give All Information Completely
Make Required Affidavit
Mail or Deliver Report to:
Conservation Division
State Corporation Commission
211 No. Broadway
Wichita, Kansas

WELL PLUGGING RECORD

NORTH

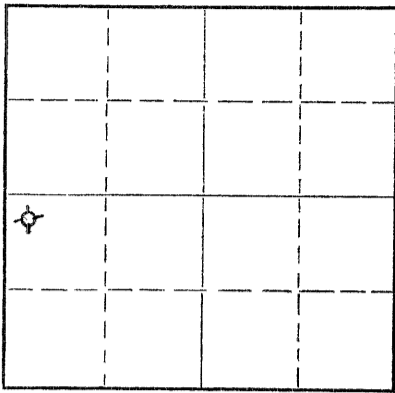

Locate well correctly on above
Section Plat

Graham County. Sec. 29 Twp. 9 Rge. 21 (E) W (W)
Location as "NE/CNW/SW" or footage from lines NW NW SW
Lease Owner C-G Drilling Co.
Lease Name Harrold Well No. 1
Office Address 107 Rule Bldg., Wichita, Kansas
Character of Well (completed as Oil, Gas or Dry Hole) Dry Hole
Date well completed November 23 1956
Application for plugging filed November 23 1956
Application for plugging approved November 23 1956
Plugging commenced November 24 1956
Plugging completed November 24 1956
Reason for abandonment of well or producing formation Too low structurally

If a producing well is abandoned, date of last production _____ 19____
Was permission obtained from the Conservation Division or its agents before plugging was commenced? Yes

Name of Conservation Agent who supervised plugging of this well Eldon Petty, Hays, Kansas
Producing formation _____ Depth to top _____ Bottom _____ Total Depth of Well 3938 Feet
Show depth and thickness of all water, oil and gas formations.

OIL, GAS OR WATER RECORDS

CASING RECORD

FORMATION	CONTENT	FROM	TO	SIZE	PUT IN	PULLED OUT
				8-5/8"	186'	none

Describe in detail the manner in which the well was plugged, indicating where the mud fluid was placed and the method or methods used in introducing it into the hole. If cement or other plugs were used, state the character of same and depth placed, from _____ feet to _____ feet for each plug set.

Filled hole with heavy mud to 181'. Set plug. Put in 1/2 sack Hulls and 10 sacks cement. Filled with heavy mud to 40'. Set plug. Filled to top with 1/2 sack Hulls and 10 sacks cement.

RECEIVED
STATE CORPORATION COMMISSION
11/30/56
MAY 30 1956
CONSERVATION DIVISION
Wichita, Kansas

(If additional description is necessary, use BACK of this sheet)
Name of Plugging Contractor C-G Drilling Co.
Address 107 Rule Building, Wichita, Kansas

STATE OF KANSAS, COUNTY OF SEDGWICK, ss.
G. F. Galloway (employee of owner) or (owner or operator) of the above-described well, being first duly sworn on oath, says: That I have knowledge of the facts, statements, and matters herein contained and the log of the above-described well as filed and that the same are true and correct. So help me God.

(Signature) G. F. Galloway
107 Rule Bldg.
(Address)

SUBSCRIBED AND SWORN to before me this 26th day of November, 1956

My commission expires May 20, 1959

Vicky Jacobs
Vicky Jacobs Notary Public.

PLUGGING
FILE SEC 29 T. 9 R. 21W
BOOK PAGE 120 LINE 38

CONTRACTOR'S WELL LOG

OPERATOR C-G DRILLING CO. WELL NAME HARROLD #1
 LOCATION NW NW SW SECTION 29-9-21W RIG NO. 2
 COUNTY GRAHAM STATE KANSAS
 COMMENCEMENT DATE NOVEMBER 15, 1956 COMPLETION DATE NOVEMBER 23, 1956

LOG OF WELL

Elevation 2312' rotary bushing
 All measurements taken from the top of rotary bushing

FROM	TO	FORMATION	DEVIATION FROM VERTICAL	REMARKS
0	186	Surface Soil		
186	660	Shale		
660	775	Sand		
775	1000	Sand-Shale		
1000	1550	Shale-Shells		
1550	1575	Shale-Shells		
1575	1780	Red Bed		
1780	1821	Anhydrite		
1821	2110	Shale-Shells		
2110	2220	Shale-Shells		
2220	2420	Shale-Lime		
2420	2550	Shale-Lime	0° - 2500	
2550	2680	Shale-Lime		
2680	2880	Shale-Lime	0° - 2750	
2880	3005	Shale-Lime	0° - 3000	
3005	3120	Shale-Lime		
3120	3360	Shale-Lime	0° - 3250	
3360	3455	Shale-Lime		
3455	3553	Shale-Lime	0° - 3500	
3553	3618	Shale-Lime		
3618	3755	Lime	0° - 3750	
3755	3794	Lime-Shale		
3794	3938	Lime		

RECEIVED
 STATE CORPORATION COMMISSION
 NOV 30 1956
 CONSERVATION DIVISION
 Wichita, Kansas

CASING LEFT IN HOLE AFTER COMPLETION

Ran 186' (9 jts.) 8-5/8" Surface Casing.

STATE OF KANSAS }
 COUNTY OF SEDGWICK } SS.

The undersigned hereby certifies that to the best of his knowledge and belief, the above facts are true and correct.

C-G DRILLING CO.

By G. J. Gallaway

Subscribed and sworn to before me this 26th day of November, 1956.

My commission expires:
 May 20, 1959

Vicky Jacobs
 Vicky Jacobs, Notary Public

PLUGGING
 FILE SEC 29 T 9 R 21W
 BOOK PAGE 120 LINE 38