


Give All Information Completely
Make Required Affidavit
Mail or Deliver Report to:
Conservation Division
State Corporation Commission
800 Biting Building
Wichita, Kansas

WELL PLUGGING RECORD

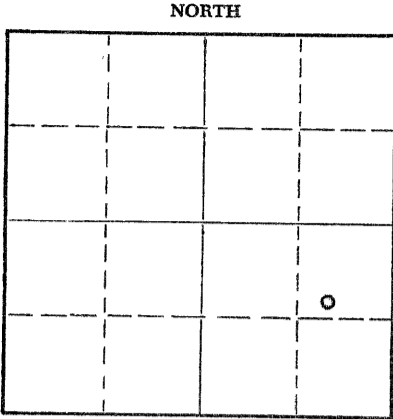

Locate well correctly on above
Section Plat

Graham County. Sec. 29 Twp. 9S Rge. 21 XX (W)

Location as "NE/CNW/SW" or footage from lines SW NE SE
Lease Owner K & E DRILLING, INC.
Lease Name Ford Well No. #1
Office Address 1006 Central Bldg., Wichita, Kansas
Character of Well (completed as Oil, Gas or Dry Hole) dry hole
Date well completed January 7, 1955
Application for plugging filed January 7, 1955
Application for plugging approved January 7, 1955
Plugging commenced 8:00 a.m., January 7, 1955
Plugging completed 2:00 p.m., January 7, 1955
Reason for abandonment of well or producing formation
commercial quantities of oil not found
If a producing well is abandoned, date of last production _____ 19____
Was permission obtained from the Conservation Division or its agents before plugging was commenced? yes

Name of Conservation Agent who supervised plugging of this well Eldon Petty, Box 326, Hays, Kansas
Producing formation _____ Depth to top _____ Bottom _____ Total Depth of Well 3956 Feet
Show depth and thickness of all water, oil and gas formations.

OIL, GAS OR WATER RECORDS

CASING RECORD

FORMATION	CONTENT	FROM	TO	SIZE	PUT IN	PULLED OUT
				8 5/8	223'	

Describe in detail the manner in which the well was plugged, indicating where the mud fluid was placed and the method or methods used in introducing it into the hole. If cement or other plugs were used, state the character of same and depth placed, from _____ feet to _____ feet for each plug set.

Filled hole with heavy mud from 3956' to 210'. Set wooden plug with fifteen sacks cement. Second plug at 40' capped with 10 sacks cement

1/11/55

Name of Plugging Contractor K & E Drilling, Inc. (If additional description is necessary, use BACK of this sheet)
Address 1006 Central Bldg., Wichita, Kansas

STATE OF KANSAS, COUNTY OF SEDGWICK, ss.
Dale Silcott (employee of owner) or (~~owner or operator~~) of the above-described well, being first duly sworn on oath, says: That I have knowledge of the facts, statements, and matters herein contained and the log of the above-described well as filed and that the same are true and correct. So help me God.

(Signature) Dale Silcott
1006 Central Bldg., Wichita, Kansas
(Address)

SUBSCRIBED AND SWORN TO before me this 10th day of January, 1955

My commission expires June 25, 1956 Francesa Masler Notary Public.

PLUGGING
FILE SEC 29 T 9 R 21
BOOK PAGE 90 LINE 2

15-065-00744-00-00

K & E DRILLING, INC.
Ford #1

SW NE SE 29-9S-21W
Graham County, Kansas

Comm: December 27, 1954
Comp: January 7, 1955
Total Depth: 3956'

Casing Cement
8 5/8' Set @ 223' 140 sacks

<u>FORMATION</u>	<u>DEPTH</u>
Surface soil and sand	0 - 110
Sand & shale	110 - 200
Shale	200 - 625
Shale, shells	625 - 1330
Sand	1330 - 1560
Red bed	1560 - 1630
Red bed & sand	1630 - 1820
Anhydrite	1820 - 1855
Shale & shells	1855 - 2260
Lime, shale	2260 - 3586
Lime	3586 - 3625
Lime & shale	3625 - 3670
Lime	3670 - 3800
Lime - shale (cherty)	3800 - 3853
Lime	3853 - 3930
Conglomerate	3930 - 3953
Arbuckle lime	3953 - 3956

STATE OF KANSAS)
) SS
SEDGWICK COUNTY)

I hereby certify that the above information is true and correct to the best of my knowledge.

Bob Silcott

Subscribed and sworn to before me this 10th day of January, 1955

Francis Walker

Notary Public

My commission expires: June 25, 1956

PLUGGING
FILE SEC 29 T 9 R 21 W
BOOK PAGE 90 LINE 7