


STATE OF KANSAS
STATE CORPORATION COMMISSION

Give All Information Completely
Make Required Affidavit
Mail or Deliver Report to:
Conservation Division
State Corporation Commission
800 Bittling Building
Wichita, Kansas

WELL PLUGGING RECORD

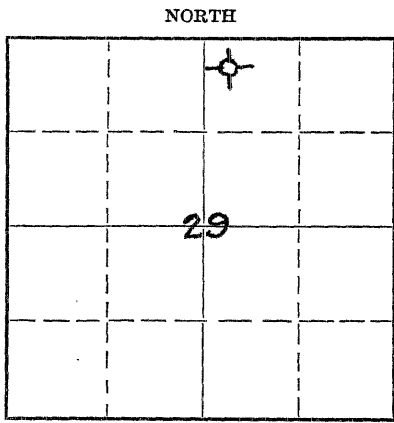

Locate well correctly on above
Section Plat

Graham County. Sec. 29 Twp. 9S Rge. 21 (E) (W)
Location as "NE/CNW 1/4 SW 1/4" or footage from lines NW NW NE
Lease Owner H. E. Zoller
Lease Name A. E. Ford Well No. 1
Office Address Central Bldg., Wichita, Kansas
Character of Well (completed as Oil, Gas or Dry Hole) Dry Hole
Date well completed July 30 19 51
Application for plugging filed July 30 19 51
Application for plugging approved July 30 19 51
Plugging commenced July 30 19 51
Plugging completed July 30 19 51
Reason for abandonment of well or producing formation Dry Hole
If a producing well is abandoned, date of last production 19
Was permission obtained from the Conservation Division or its agents before plugging was commenced? Yes

Name of Conservation Agent who supervised plugging of this well Eldon Petty
Producing formation Depth to top Bottom Total Depth of Well Feet
Show depth and thickness of all water, oil and gas formations.


OIL, GAS OR WATER RECORDS

CASING RECORD

Formation	Content	From	To	Size	Put In	Pulled Out
Surface Casing		0	162'	8-5/8"	162'	None

Describe in detail the manner in which the well was plugged, indicating where the mud fluid was placed and the method or methods used in introducing it into the hole. If cement or other plugs were used, state the character of same and depth placed, from feet to feet for each plug set.

Filled with heavy mud from 3980 to 155'. Set wooden plug at 155' with 1/2 Sk hulls and 15 sks cement to 40 feet. Set wooden plug at 40 feet and filled hole to bottom of cellar with 10 sacks of cement.

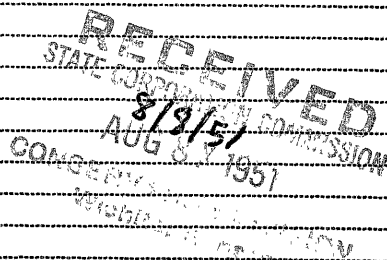

(If additional description is necessary, use BACK of this sheet)

Name of Plugging Contractor Peel Bros. Drlg. Co.
Address Hoisington, Kansas

STATE OF Kansas, COUNTY OF Sedgwick, ss.
H. E. Zoller (employee of owner) or (owner or operator) of the above-described well,
being first duly sworn on oath, says: That I have knowledge of the facts, statements, and matters herein contained and the log of the above-described well as filed and that the same are true and correct. So help me God.

(Signature) H. E. Zoller
Central Bldg., Wichita, Kansas
(Address)

SUBSCRIBED AND SWORN TO before me this 6th day of August, 19 51.

My commission expires March 7, 1953 Notary Public.

PLUGGING 23-8390-s 6-51-20M
FILE SEC 29 T 9 R 20
BOOK PAGE 99 LINE 20

