


STATE OF KANSAS  
STATE CORPORATION COMMISSION

WELL PLUGGING RECORD

Give All Information Completely  
Make Required Affidavit  
Mail or Deliver Report to  
Conservation Division  
State Corporation Comm.  
245 North Water  
Wichita, KS 67202

Graham County. Sec. 29 Twp. 9S Rge. 21E/W  
Location as "NE/CNW $\frac{1}{4}$ SW $\frac{1}{4}$ " or footage from lines  
SE SE SE

Lease Owner Earl M. Knighton  
Lease Name Ford Well No. 1  
Office Address 710 Petroleum Building - Wichita, Ks.  
Character of Well (Completed as Oil, Gas or Dry Hole)

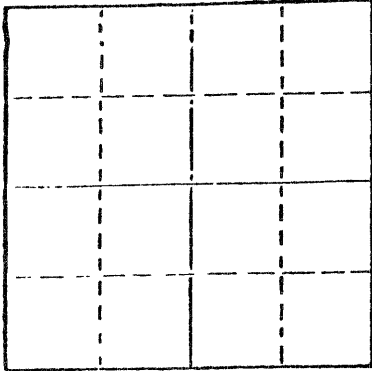

Locate well correctly on above  
Section Plot

Attempt to re-enter former producer  
Date Well completed March 1 19 77  
Application for plugging filed May 12 19 77  
Application for plugging approved 19  
Plugging commenced May 14 19 77  
Plugging completed May 14 19 77  
Reason for abandonment of well or producing formation  
Could not make hole

If a producing well is abandoned, date of last production 19

Was permission obtained from the Conservation Division or  
its agents before plugging was commenced? Yes

Name of Conservation Agent who supervised plugging of this well Gilbert Balthazor  
Producing formation Depth to top Bottom Total Depth of Well 885'  
Show depth and thickness of all water, oil and gas formations.

OIL, GAS OR WATER RECORDS

CASING RECORD

FORMATION	CONTENT	FROM	TO	SIZE	PUT IN	PULLED OUT
Former Producer had				8 5/8"	25518'	None
" " "				5 1/2"	3911'	2464'

Describe in detail the manner in which the well was plugged, indicating where the mud fluid was placed and the method or methods used in introducing it into the hold. If cement or other plugs were used, state the character of same and depth placed, from feet to feet for each plug set.

Checked hole to 885', Ran 1 Sx Hulls,  
60 Sks Cement (50-50 Common & Pozmix),  
10 Sks Gel, 40 Sks Cement (50-50 Common  
& Poz/Mix), Held 100# Pressure 24Hrs.

Plugging Complete.

6/30/77

(If additional description is necessary, use BACK of this sheet)

Name of Plugging Contractor Allied Cementing Company

STATE OF Kansas COUNTY OF Sedgwick, ss.  
Earl M. Knighton (employee of owner) or (owner or operator)  
of the above-described well, being first duly sworn on oath, says: That I have knowledge of the facts, statements, and matters herein contained and the log of the above-described well as filed and that the same are true and correct. So help me God.

(Signature)

*Earl M. Knighton*

710 Petroleum Building-Wichita, Ks.  
(Address)

SUBSCRIBED AND SWORN TO before me this 29 day of June, 1977

*Anna Marie Olden*  
Notary Public.



July 11 1979