

15-065-00095-00-00

STATE OF KANSAS
STATE CORPORATION COMMISSION

WELL PLUGGING RECORD


OR

FORMATION PLUGGING RECORD

Strike out upper line
when reporting plugging
off formations.

Give All Information Completely
Make Required Affidavit
Mail or Deliver Report to:
Conservation Division
State Corporation Commission
800 Bitting Building
Wichita, Kansas

Graham County. Sec. 30 Twp. 9S Rge. (E) 21 (W)
Location as "NE 1/4 NW 1/4 SW 1/4" or footage from lines. NE NE NE
Lease Owner Derby Oil Company, R. W. Shields, Peel-Hardman Producers
Lease Name Smith Well No. 1
Office Address P.O. Box 1030, Wichita, Kansas
Character of Well (completed as Oil, Gas or Dry Hole) Dry Hole
Date well completed December 27 19 48
Application for plugging filed December 26 19 48
Application for plugging approved December 27 19 48
Plugging commenced December 27 19 48
Plugging completed December 27 19 48
Reason for abandonment of well or producing formation Dry Hole

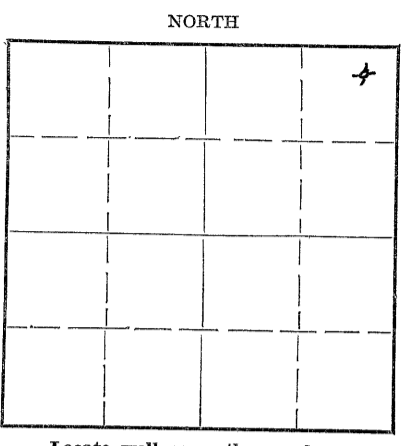

Locate well correctly on above
Section Plat

If a producing well is abandoned, date of last production 19...
Was permission obtained from the Conservation Division or its agents before plugging was commenced? Yes

Name of Conservation Agent who supervised plugging of this well C. D. Stough
Producing formation Depth to top Bottom Total Depth of Well 4000 Feet
Show depth and thickness of all water, oil and gas formations.

OIL, GAS OR WATER RECORDS

CASING RECORD

Formation	Content	From	To	Size	Put In	Pulled Out
		0	168'	8 5/8"	168'	None

Describe in detail the manner in which the well was plugged, indicating where the mud fluid was placed and the method or methods used in introducing it into the hole. If cement or other plugs were used, state the character of same and depth placed, from... feet to ... feet for each plug set.

- 4000' - 166 1/2' - Heavy Rotary Mud
- 166 1/2' - 165' - Wooden Plug
- 165' - 127 1/2' - 15 sacks cement
- 127 1/2' - 41 1/2' - Heavy Rotary Mud
- 41 1/2' - 40' - Wooden Plug
- 40' - 6' - 14 sacks cement
- 6' - Surface - Cellar

RECEIVED
1/13/49
JAN 13 1949

(If additional description is necessary, use BACK of this sheet)

Correspondence regarding this well should be addressed to The Derby Oil Company
Address P.O. Box 1030
Wichita, Kansas

STATE OF Kansas COUNTY OF Barton, ss.
Glenn Peel Drilling Company, Inc.

(employee of owner) or (owner/operator) of the above-described well,
being first duly sworn on oath, says: That I have knowledge of the facts, statements, and matters herein contained and the log of the above-described well as filed and that the same are true and correct. So help me God. GLENN PEEL DRILLING CO., INC.


(Signature) R. B. Sutton
BY:

SUBSCRIBED AND SWORN to before me this 4th day of January, 19 49 (Address)

My commission expires June 4, 1951

Marian M. Herbst

Notary Public.

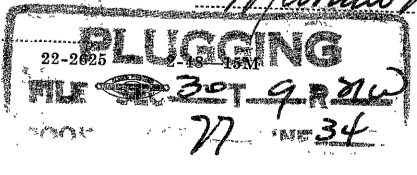

DRILLER'S LOG

Company: Derby Oil Company
 R. W. Shields
 Peel-Hardman Producers

Sec. 30 Twp. 9S Rge. 21W
 NE NE NE

Farm: Smith Well No. 1

County: Graham
 Kansas

Total Depth: 4000' (Rotary)
 Comm.: 12-15-48 Comp.: 12-27-48
 Contractor: Glenn Peel Drilling Co., Inc.

Elevation:
 Production: Dry

Casing:
 8 5/8" 168' cem.

Figures below indicate bottom of formations

Clay, Sand and Shells	0 -	168
Shells and Shale		830
Shale and Shells		1838
Anhydrite		1880
Shale and Shells		2320
Lime and Shale		2530
Sand, Lime and Shale		2735
Shale and Lime		2890
Lime and Shale		3090
Broken Lime		3210
Lime and Shale		3385
Lime		3495
Lime and Shale		3580
Lime		3865
Conglomerate		3917
Lime and Chert		3932
Chert and Lime		4000
Total Depth (Rotary)		4000

This is to certify that the above information is, to the best of our knowledge, true and correct.

GLENN PEEL DRILLING COMPANY, INC.

BY: *R. E. Sutton*

SUBSCRIBED AND SWORN to before me this 4th day of January, 1949

My commission expires June 4, 1951 *Marian M. Herbert*
 Notary Public

