

STATE OF KANSAS
STATE CORPORATION COMMISSION

WELL PLUGGING RECORD

Give All Information Completely
Make Required Affidavit
Mail or Deliver Report to:
Conservation Division
State Corporation Commission
211 No. Broadway
Wichita, Kansas

Graham County, Sec. 30 Twp. 9S Rge. 21W(E) (W)

Location as "NE/CNW/SW" or footage from lines NW NW SE
Lease Owner Mayfield-Smith Drilling, Inc.

Lease Name Eichman Well No. 1

Office Address 928 Union Center, Wichita, Kansas

Character of Well (completed as Oil, Gas or Dry Hole) Dry Hole

Date well completed November 5, 19 65

Application for plugging filed November 5, 19 65

Application for plugging approved November 5, 19 65


Plugging commenced November 5, 19 65

Plugging completed November 5, 19 65

Reason for abandonment of well or producing formation D & A

If a producing well is abandoned, date of last production 19

Was permission obtained from the Conservation Division or its agents before plugging was commenced? Yes

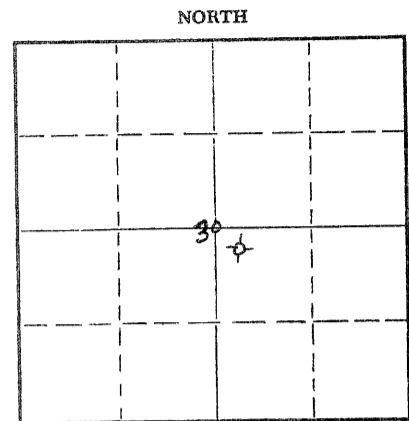

Locate well correctly on above Section Plat

Name of Conservation Agent who supervised plugging of this well W. L. Nichols

Producing formation Depth to top Bottom Total Depth of Well 3940 Feet

Show depth and thickness of all water, oil and gas formations.

OIL, GAS OR WATER RECORDS

CASING RECORD

FORMATION	CONTENT	FROM	TO	SIZE	PUT IN	PULLED OUT
				8 5/8"	217'	-0-

Describe in detail the manner in which the well was plugged, indicating where the mud fluid was placed and the method or methods used in introducing it into the hole. If cement or other plugs were used, state the character of same and depth placed, from feet to feet for each plug set.

Mud up to 540', set plug,
20 sacks cement, mud up to
200', set plug, 20 sacks
cement, mud up to 40', 1/2
sack hulls, 10 sacks cement.

RECEIVED
STATE CORPORATION COMMISSION
11/16/65
NOV 16 1965

CONSERVATION DIVISION
Wichita, Kansas

Name of Plugging Contractor Red Tiger Drilling Company
Address Box 173 -- Russell, Kansas

STATE OF KANSAS, COUNTY OF SEDGWICK, ss.

Maxine V. Starr (employee of owner) or (owner or operator) of the above-described well, being first duly sworn on oath, says: That I have knowledge of the facts, statements, and matters herein contained and the log of the above-described well as filed and that the same are true and correct. So help me God.

(Signature) Maxine V. Starr
1720 Wichita Plaza, Wichita, Kansas
(Address)

SUBSCRIBED AND SWORN TO before me this 8th day of November, 19 65

(Signature) Jean Hollar
Notary Public.

DRILLERS LOG

Eichman No. 1

CASING RECORD: 8 5/8" @ 217' w/150 sx cement
 COMPANY: Mayfield-Smith Drilling, Inc.
 CONTRACTOR: Red Tiger Drilling Company
 COMMENCED: October 28, 1965
 COMPLETED: November 5, 1965

DESCRIPTION: NW NW SE
 30-9S-21W
 Graham Co., Ks.
 ELEVATION:

TOTAL DEPTH: 3940'

<u>FORMATION</u>	<u>FROM</u>	<u>TO</u>	<u>REMARKS</u>
Surface & Clay & Shale	0	80	
Sand	80	115	
Shale	115	620	
Shale & Shells	620	1360	
Sand	1360	1560	
Redbed & Shale	1560	1605	
Shale & Shells & Redbed	1605	1845	
Anhydrite	1845	1885	
Shale & Shells	1885	2415	
Shale & Lime	2415	3455	
Lime	3455	3905	
Conglomerate	3905	3927	
Lime	3927	3940	

RECEIVED
 STATE CORPORATION COMMISSION

NOV 16 1965

CONSERVATION DIVISION
 Wichita, Kansas

I certify that this is a true and correct copy of the above log to the best of my knowledge.

RED TIGER DRILLING COMPANY

Maxine V. Starr
 Maxine V. Starr

Subscribed and sworn to before me this 8th day of November, 1965.

Jean Kollar
 Notary Public

My Commission Expires:

5-22-66