


Give All Information Completely
Make Required Affidavit
Mail or Deliver Report to:
Conservation Division
State Corporation Commission
211 No. Broadway
Wichita, Kansas

WELL PLUGGING RECORD

Rooks County, Sec. 32 Twp. 9 Rge. 18 (E) W (W)

T - 9 NORTH R - 18W

Location as "NE/CNW&SW&" or footage from lines C SE NW
Lease Owner Frank J. Black
Lease Name Kuenster Well No. 1
Office Address McPherson, Kansas
Character of Well (completed as Oil, Gas or Dry Hole) Oil
Date well completed 6-9-59 19
Application for plugging filed 9-10-63 19
Application for plugging approved 9-11-63 19
Plugging commenced 9-13-63 19
Plugging completed 10-4-63 19
Reason for abandonment of well or producing formation Depleted.

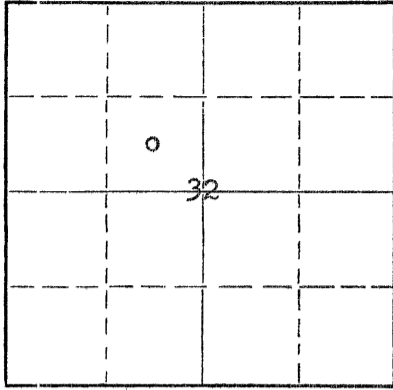

Locate well correctly on above Section Plat

If a producing well is abandoned, date of last production _____ 19____
Was permission obtained from the Conservation Division or its agents before plugging was commenced? yes

Name of Conservation Agent who supervised plugging of this well Eldon Petty
Producing formation _____ Depth to top _____ Bottom _____ Total Depth of Well 3700 Feet
Show depth and thickness of all water, oil and gas formations.

OIL, GAS OR WATER RECORDS

CASING RECORD

FORMATION	CONTENT	FROM	TO	SIZE	PUT IN	PULLED OUT
				8-5/8"	225'	None
				5-1/2"	3690'	2417'

Describe in detail the manner in which the well was plugged, indicating where the mud fluid was placed and the method or methods used in introducing it into the hole. If cement or other plugs were used, state the character of same and depth placed, from _____ feet to _____ feet for each plug set.

Checked hole to 3700', sanded to 3680' and dumped 5 sacks of cement @ 3680' with dump bailer. Pulled pipe to 362' and circulated with 20 sacks of mud. Pumped in 25 sacks of cement @ 362'. Pulled casing to 30' and pumped in 10 sacks of cement to base of cellar.

RECEIVED
STATE CORPORATION COMMISSION
10/11/63
OCT 11 1963

PLUGGING COMPLETE.

CONSERVATION DIVISION
Wichita, Kansas

Name of Plugging Contractor KNIGHT CASING PULLING COMPANY License No. 436
Address CHASE, KANSAS

STATE OF KANSAS, COUNTY OF RICE, ss. Noel J. Knight (employee of owner) or (owner/operator) of the above-described

well, being first duly sworn on oath, says: That I have knowledge of the facts, statements, and matters herein contained and the log of the above-described well as filed and that the same are true and correct. So help me God.

(Signature) Noel J. Knight
Chase, Kansas
(Address)

SUBSCRIBED AND SWORN TO before me this 7th day of October, 1963

My commission expires May 20, 1964 Milton J. Volin Notary Public.

15-163-19295-00-00

KANSAS GEOLOGICAL SOCIETY
KANSAS WELL LOG BUREAU - KANSAS WELL SAMPLE BUREAU
KANSAS GEOLOGICAL SOCIETY BUILDING
508 EAST MURDOCK - WICHITA, KANSAS

COMPANY **Grant Oil Company**

SEC. 32 T. 9 R. 18N

FARM **Kuenster** NO. 1

LOC. C SE NW

TOTAL DEPTH **3700'**

COUNTY **Rooks**

COMM. **6-1-59**


COMP. **6-9-59**

KANSAS

SHOT OR TREATED

CONTRACTOR **Honaker-Davis Drig.**

ISSUED **1-21-61**

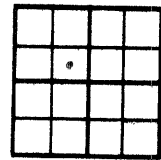

CASING

20	10	^{295'} 324'	cem w/ 185 sx
15	8	5/8"	
12	6		
13	5 1/2"	3690'	cem w/ 100 sx

ELEVATION **2178 RB**

PRODUCTION **158 BOPD**

FIGURES INDICATE BOTTOM OF FORMATIONS

clay	35
shale & sand	150
shale	1060
sand	1250
shale	1450
shale & red bed	1574
anhydrite	1612
shale	2025
lime & shale	3524
lime	3555
lime & shale	3678
lime & chert	3700 RTD
Total Depth	

TOPS: LOG

Topeka	3132
Heebner	3344
Toronto	3367
Lansing	3385
Kansas City	3604
Conglomerate	3623
Upper Simpson Dolomite	3684
Lower Simpson Dolomite	3690

RECEIVED
STATE CORPORATION COMMISSION

10/11/63
OCT 11 1963

CONSERVATION DIVISION
Wichita, Kansas