


STATE OF KANSAS
STATE CORPORATION COMMISSION

Form CP-4

WELL PLUGGING RECORD

Give All Information Completely
Make Required Affidavit
Mail or Deliver Report to:
Conservation Division
State Corporation Commission
212 No. Market
Wichita, Kansas

NORTH

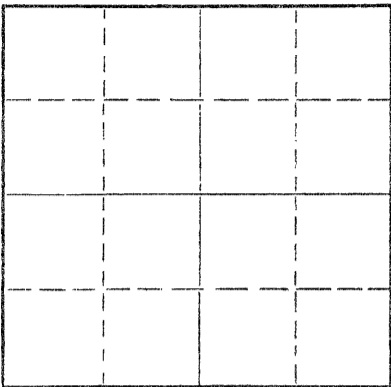

Locate well correctly on above
Section Plat

Rooks County. Sec. 32 Twp. 9 Rge. 18 (E) (W)
Location as "NE/CNW%SW%" or footage from lines. S/2 NW SE
Lease Owner Tomlinson Kathol, Inc.
Lease Name Richardson Well No. 3
Office Address Wichita, Kansas
Character of Well (completed as Oil, Gas or Dry Hole) _____
Date well completed _____ 19____
Application for plugging filed _____ 19____
Application for plugging approved _____ 19____
Plugging commenced 12/15/66 _____ 19____
Plugging completed 12/17/66 _____ 19____
Reason for abandonment of well or producing formation depleted

If a producing well is abandoned, date of last production _____ 19____
Was permission obtained from the Conservation Division or its agents before plugging was commenced? yes

Name of Conservation Agent who supervised plugging of this well I. Massey
Producing formation _____ Depth to top _____ Bottom _____ Total Depth of Well 3689 Feet
Show depth and thickness of all water, oil and gas formations.

OIL, GAS OR WATER RECORDS

CASING RECORD

| FORMATION | CONTENT | FROM | TO | SIZE | PUT IN | PULLED OUT |
|-----------|---------|------|----|-------|--------|------------|
| | | | | 8 5/8 | 208 | none |
| | | | | 5 1/2 | 3685 | 3133 |
| | | | | | | |
| | | | | | | |
| | | | | | | |
| | | | | | | |
| | | | | | | |
| | | | | | | |

Describe in detail the manner in which the well was plugged, indicating where the mud fluid was placed and the method or methods used in introducing it into the hole. If cement or other plugs were used, state the character of same and depth placed, from _____ feet to _____ feet for each plug set.

Rigged up, checked hole to 3689, ran sand to 2670, mixed and dumped 5 sacks of cement. Dug cellar and rigged up over 5 1/2 casing, worked tension to 23". Had hole loaded with 75 barrels water, shot pipe at 3300', worked tension at no gain. Shot at 3100' and worked pipe loose, pulled 90 joints. Pulled 43 joints of 5 1/2, loaded junk rack. Lowered mast. Had Globe squeeze well with 26 sacks mud and 75 sacks cement.

RECEIVED
STATE CORPORATION COMMISSION
1/3/67
JAN 3 1967

CONSERVATION DIVISION
WICHITA, KANSAS

(If additional description is necessary, use BACK of this sheet)
Name of Plugging Contractor KNIGHT CASING PULLING COMPANY
Address CHASE, KANSAS

STATE OF KANSAS, COUNTY OF RICE, ss.
NOEL J. KNIGHT (employee of owner) or (owner or operator) of the above-described well, being first duly sworn on oath, says: That I have knowledge of the facts, statements, and matters herein contained and the log of the above-described well as filed and that the same are true and correct. So help me God.

(Signature) Noel J. Knight
CHASE, KANSAS
(Address)

SUBSCRIBED AND SWORN TO before me this 21 day of Dec, 1966

My commission expires Oct 22-1970
[Signature] Notary Public.

15-163-19296-00000

VAUGHAN DRILLING, INC.

1618 Wichita Plaza, Wichita, Kansas

WELL LOG

COMPANY: Tomlinson-Kathol, Inc.
 CONTRACTOR: Vaughan Drilling, Inc.
 FARM: #3 Richardson
 S/2 NW NE Sec. 32-9S-18W
 Rooks County, Kansas
 ELEVATION: 2159 Kelly Bushing
 SURFACE PIPE: 209' of 8 5/8" W/135 Sx. Cement
 OIL STRING: 5 1/2" Set at 3685'
 COMMENCED: October 7, 1966
 COMPLETED: October 15, 1966

RECEIVED
 STATE CORPORATION COMMISSION
 12/21/66
 DEC 21 1966

CONSERVATION DIVISION
 Wichita, Kansas

| <u>DEPTH</u> | <u>FORMATION</u> | <u>SAMPLE TOPS</u> | |
|--------------|---------------------|---------------------|------|
| 0 - 30 | Clay & Sand | Topeka | 3150 |
| 30 - 208 | Shale | Heebner | 3328 |
| 208 - 764 | Shale & Red Bed | Toronto | 3353 |
| 764 - 790 | Shale & Sand | Lansing | 3372 |
| 790 - 955 | Sand | Simpson Dolomite | 3670 |
| 955 - 1270 | Shale & Sand | Lower Simpson Dolo. | 3684 |
| 1270 - 1537 | Red Bed | R.T.D. | 3689 |
| 1537 - 1574 | Anhydrite | | |
| 1574 - 1975 | Shale & Shells | | |
| 1975 - 3026 | Lime & Shale | | |
| 3026 - 3130 | Lime | | |
| 3130 - 3250 | Shale & Lime | | |
| 3250 - 3555 | Lime | | |
| 3555 - 3630 | Lime & Conglomerate | | |
| 3630 - 3689 | Chert, Shale & Lime | | |

AFFIDAVIT

STATE OF KANSAS)
) SS
 COUNTY OF SEDGWICK)

I, Donald D. Vaughan, President of Vaughan Drilling, Inc., being first duly sworn on oath, state: That I have knowledge of the facts, statements and matters herein contained and that the same are true and correct.

Donald D. Vaughan
 Donald D. Vaughan

Subscribed and sworn to before me this 17th day of October, 1966.

Marguerite Mayfield
 Marguerite Mayfield, Notary Public

My Commission Expires: 10-26-69

