


STATE OF KANSAS
STATE CORPORATION COMMISSION

All Information Completely
Like Required Affidavit
File or Deliver Report to:
Conservation Division
State Corporation Commission
800 Bitting Building
Wichita, Kansas

WELL PLUGGING RECORD

Rooks County. Sec. 1 Twp. 9 Rge. 19 ~~XX~~ (W)

Location as "NE/CNW $\frac{1}{4}$ SW $\frac{1}{4}$ " or footage from lines NE NE NE
Lease Owner Phillips and Hanson
Lease Name Gick Well No. 1
Office Address Union Nat'l Bank Bldg., Wichita, Kansas
Character of Well (completed as Oil, Gas or Dry Hole) Dry Hole
Date well completed 6-21 1950
Application for plugging filed 6-21 1950
Application for plugging approved 6-21 1950
Plugging commenced 6-21 1950
Plugging completed 6-21 1950
Reason for abandonment of well or producing formation Dry

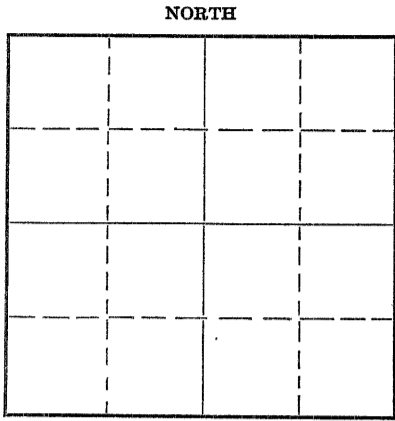

Locate well correctly on above
Section Plat

If a producing well is abandoned, date of last production 19...
Was permission obtained from the Conservation Division or its agents before plugging was com-
menced? Yes

Name of Conservation Agent who supervised plugging of this well C. D. Stough
Producing formation Depth to top Bottom Total Depth of Well 3560' Feet
Show depth and thickness of all water, oil and gas formations.

OIL, GAS OR WATER RECORDS

CASING RECORD

Formation	Content	From	To	Size	Put In	Pulled Out
				8-5/8"	190'	

Describe in detail the manner in which the well was plugged, indicating where the mud fluid was placed and the method or methods used in introducing it into the hole. If cement or other plugs were used, state the character of same and depth placed, from feet to feet for each plug set.

Bottom plug set at 190' with 15 sacks cement through drill pipe
Top plug set at 30' with 10 sacks cement through drill pipe

6/28/50
R. J. ...

(If additional description is necessary, use BACK of this sheet)

Correspondence regarding this well should be addressed to Anschutz Drilling Company, Inc.
Address 709 Union National Bank Bldg., Wichita, Kansas


STATE OF KANSAS, COUNTY OF SEDGWICK, ss.
M. W. Smith (employee of owner) or (owner or operator) of the above-described well,
being first duly sworn on oath, says: That I have knowledge of the facts, statements, and matters herein contained and the log of the above-described well as filed and that the same are true and correct. So help me God.

(Signature) [Signature]
709 Union Nat'l Bk Bldg., Wichita, Kans.
(Address)

SUBSCRIBED AND SWORN TO before me this 26th day of June, 1950

My commission expires September 12, 1953

Marche [Signature]
Notary Public.

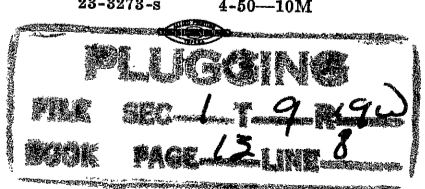

PHILLIPS AND HANSON

#1 Gick NE NE NE 1-9-19W
Rooks County, Kansas

COMMENCED: 6-9-50
COMPLETED: 6-21-50

0	100	Clay and surface rock
100	145	Shale and shells
145	190	Shale and shells
190	610	Shale
610	690	Sand rock
690	740	Red Rock
740	920	Sand rock pyrite
920	1085	DK sand
1085	1130	Sand
1130	1230	Shale and sand
1230	1420	Red bed
1420	1465	Anhydrite
1465	1575	Shale and shells
1575	1855	Shale and shells
1855	1940	Shale and shells
1940	2000	Shale and shells
2000	2135	Lime and shale
2135	2200	Lime and shale
2200	2270	Lime and shale
2270	2300	Lime and shale
2300	2395	Lime and shale
2395	2505	Lime and shale
2505	2575	Lime and shale
2575	2610	Lime and shale
2610	2695	Lime and shale
2695	2815	Lime and shale
2815	2955	Lime and shale
2955	3055	Lime and shale
3055	3115	Lime and shale
3115	3150	Lime and shale
3150	3210	Lime and shale
3210	3254	Lime
3254	3320	Lime
3320	3356	Lime
3356	3390	Lime
3390	3440	Lime and shale
3440	3453	Lime and shale
3453	3475	Lime and shale
3475	3509	Cherty Congl.
3509	3519	Arbuckle
3519	3560	Arbuckle
3560		Rotary Total Depth

CASING RECORD

Set 8-5/8" surface casing at 190' with 125 sacks cement

STATE OF KANSAS)
) SS
COUNTY OF SEDGWICK)

I hereby affirm that the above and foregoing is a true and correct copy of the #1 Gick located in the NE NE NE Section 1-9-19W, Rooks County, Kansas.

ANSCHUTZ DRILLING COMPANY, INC.

By: *[Signature]*

Subscribed and sworn to before me this 26th day of June, 1950

6/28/50

[Signature]
Notary Public

My commission expires September 12, 1953

PLUGGING
1-9-19W
13 8