


STATE OF KANSAS
STATE CORPORATION COMMISSION

15-163-00922-00-00

Give All Information Completely
Make Required Affidavit
Mail or Deliver Report to:
Conservation Division
State Corporation Commission
211 No. Broadway
Wichita, Kansas

WELL PLUGGING RECORD

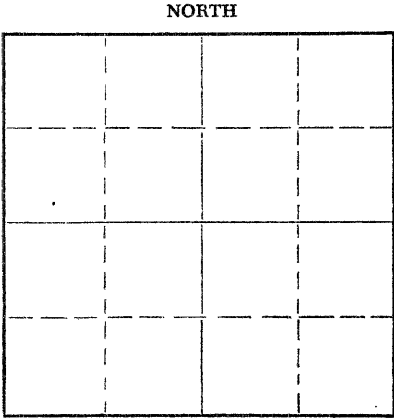

Rooks County. Sec. 1 Twp. 9S Rge. (X) 19 (W)
Location as "NE/CNW $\frac{1}{4}$ SW $\frac{1}{4}$ " or footage from lines 330' fm N, 2,310' fm W
Lease Owner Continental Oil Company
Lease Name J. E. Slansky "D" Well No. 1
Office Address _____
Character of Well (completed as Oil, Gas or Dry Hole) Dry Hole
Date well completed July 29, 19 59
Application for plugging filed July 29, 19 59
Application for plugging approved July 29, 19 59
Plugging commenced July 29, 19 59
Plugging completed July 29, 19 59
Reason for abandonment of well or producing formation No producing formations
If a producing well is abandoned, date of last production _____ 19____
Was permission obtained from the Conservation Division or its agents before plugging was commenced? Yes

Name of Conservation Agent who supervised plugging of this well A. D. Fabricius
Producing formation None Depth to top _____ Bottom _____ Total Depth of Well 3,488 Feet
Show depth and thickness of all water, oil and gas formations.

OIL, GAS OR WATER RECORDS

CASING RECORD

FORMATION	CONTENT	FROM	TO	SIZE	PUT IN	PULLED OUT
				8 5/8"	219'	None

Describe in detail the manner in which the well was plugged, indicating where the mud fluid was placed and the method or methods used in introducing it into the hole. If cement or other plugs were used, state the character of same and depth placed, from _____ feet to _____ feet for each plug set.

Filled hole to 550' with heavy mud. Set plug and cemented through drill pipe with 20 sacks of cement. Mudded to 210', set plug and cemented with 20 sacks of cement. Mudded to 40', set plug and cemented with 10 sacks of cement to base of cellar. Job completed at 5:30 PM

8/3/59
AUG 3 1959

(If additional description is necessary, use BACK of this sheet)
Name of Plugging Contractor Globe Oil Well Cementing Inc.
Address Plainville, Kansas

STATE OF Kansas, COUNTY OF Rooks, ss.
L. E. Powell (employee of owner) or (owner or operator) of the above-described well, being first duly sworn on oath, says: That I have knowledge of the facts, statements, and matters herein contained and the log of the above-described well as filed and that the same are true and correct. So help me God.

(Signature) L. E. Powell
Drawer 98 - Plainville, Kansas
(Address)

SUBSCRIBED AND SWORN TO before me this 31 day of July, 19 59

My commission expires December 2, 1961
RGW-ea
7-31-59
State Corp. Comm.
DWM
File

Kenneth J. Querry Notary Public.

PLUGGING
FILE SEC 1 T 9 R 19
BOOK PAGE 57 LINE 25


WELL LOG BUREAU—KANSAS GEOLOGICAL SOCIETY
508 East Murdock, Wichita, Kansas

15-163-00922-00-00

Company- CONTINENTAL OIL CO.
Farm- Slansky "D" No. 1

SEC. 1 T. 9 R. 19W
NE NE NW

Total Depth, 3488'
Comm. 7-22-59 Comp. 7-29-59
Shot or Treated.
Contractor. Garvey Drig. Co.
Issued. 11-7-59

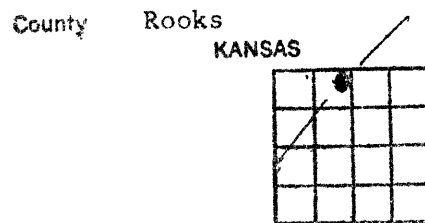

Elevation. 1988.40' DF

Production. Dry

CASING:

8 5/8" 219' cem w/175 sx

Figures indicate Bottom of Formations.

top soil & post rock	40
surface shale	219
shale & shells	500
sand	620
shale & shells	900
sand	1130
shale	1410
Anhydrite	1461
shale & shells	1940
shale	2245
shale & lime	2600
shale	2570
shale & lime	3010
lime & shale	3145
lime	3446
Conglomerate	3488
Total Depth	

TOPS: SCOUT

Topeka	2952
Heebner	3163
Toronto	3186
Lansing	3202
Conglomerate	3475