


Give All Information Completely
Make Required Affidavit
Mail or Deliver Report to:
Conservation Division
State Corporation Commission
211 No. Broadway
Wichita, Kansas

WELL PLUGGING RECORD

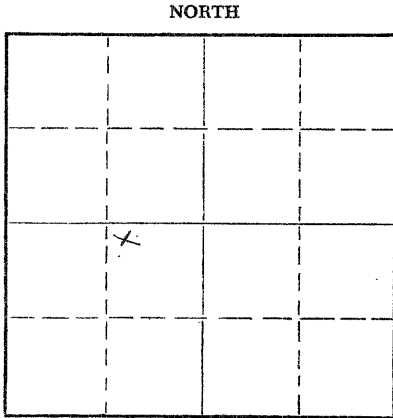

Locate well correctly on above Section Plat

Rooks _____ County, Sec. 1 Twp. 9 Rge. 19 (E) _____ (W) _____
Location as "NE/CNW%SW%" or footage from lines NW SE SW
Lease Owner Thunderbird Drilling Co.
Lease Name Gick Well No. 1
Office Address 712 Union Center Bldg.
Character of Well (completed as Oil, Gas or Dry Hole) oil
Date well completed _____ 19 _____
Application for plugging filed March 6, 19 59
Application for plugging approved March 6 19 59
Plugging commenced March 6 19 59
Plugging completed March 9 19 59
Reason for abandonment of well or producing formation dry hole

If a producing well is abandoned, date of last production _____ 19 _____
Was permission obtained from the Conservation Division or its agents before plugging was commenced? yes

Name of Conservation Agent who supervised plugging of this well Eldon Petty
Producing formation _____ Depth to top _____ Bottom _____ Total Depth of Well 3489 Feet
Show depth and thickness of all water, oil and gas formations.

OIL, GAS OR WATER RECORDS

CASING RECORD

FORMATION	CONTENT	FROM	TO	SIZE	PUT IN	PULLED OUT

Describe in detail the manner in which the well was plugged, indicating where the mud fluid was placed and the method or methods used in introducing it into the hole. If cement or other plugs were used, state the character of same and depth placed, from _____ feet to _____ feet for each plug set.

Filled back with sand to 3470 mixed and dumped 1/2 sacks cement
circulated pipe with 21 sacks fill mud and spotted 20 sacks cement at 600'
pulled pipe to 150' and spotted 20 sacks cement
Bailed fluid down set 10' rock bridge at 40' mixed and run 10 sacks cement to base of
cellar.

RECEIVED
STATE CORPORATION COMMISSION
3/25/59
MAR 25 1959
CONSERVATION DIVISION
Wichita, Kansas

(If additional description is necessary, use BACK of this sheet)
Name of Plugging Contractor Southwest Casing Pulling Co., Inc.
Address Box 364, Great Bend, Kansas

STATE OF Kansas, COUNTY OF Barton, ss.
Southwest Casing Pulling Co., Inc. (employee of owner) or (owner or operator) of the above-described well, being first duly sworn on oath, says: That I have knowledge of the facts, statements, and matters herein contained and the log of the above-described well as filed and that the same are true and correct. So help me God.

(Signature) [Signature] Roy L. Myers Sec. Treas.
Box 364, Great Bend, Kansas (Address)

SUBSCRIBED AND SWORN TO before me this 24 day of March, 19 59

My commission expires December 18, 1962

[Signature]
Notary Public.

PLUGGING
FILE SEC. 1 T. 9 R. 19w
BOOK PAGE 25 LINE 7

15-163-03214-00-00

GICK #1

CONTRACTOR: Thunderbird Drilling, Inc. Com. 1- 6-55
 1311 Union Nat'l Bank Bldg. Comp. 1-19-55
 Wichita 2, Kansas

LOCATION: NW SE SW
 Sec. 1, S.S, 19.W
 Reels County, Kansas

SURFACE CASING: 180' 8 5/8" Surface Casing
 Cemented with 115 sacks cement
 1 sack Calcium Chloride, 2% jel

OIL STRING: 3488' 5 1/2" oil string
 cemented with 75 sacks cement.

WELL LOG

0 -	60	Surface Clay and rock
60 -	180	Shale and shells
180 -	540	Shale
540 -	760	Sand
760 -	925	Shale
925 -	1100	Sand
1100 -	1425	Shale
1425 -	1475	Anhydrite
1475 -	2070	Shale and shells
2070 -	2450	Shale and lime
2450 -	2500	Lime
2500 -	2550	Shale and lime
2550 -	2645	Shale and shells
2645 -	3200	Shale and lime
3200 -	3480	Lime
3480 -	3483	Shale and lime
3483 -	3489	Lime
3489		Rotary Total Depth


RECEIVED
 STATE DEPARTMENT OF CONSERVATION
 APR 29 1959
 CONSERVATION
 WICHITA, KANSAS

The undersigned, Charles W. Aikins, Jr., an officer of Thunderbird Drilling, Inc., hereby certifies that the above is a true and correct log of the formations encountered in the drilling of the #1 Gick as shown in the daily drilling reports.

THUNDERBIRD DRILLING, INC.


 Charles W. Aikins, Jr., Pres.

Subscribed and sworn to before me this 20th day of January, 1955.


 Notary Public

My commission expires:
 August 25, 1956

PLUGGING
 FILE SEC. 1 T. 9 R. 19W
 BOOK PAGE 25 LINE 7