


15-163-21523-00-00

WELL PLUGGING RECORD

Give All Information Completely
Make Required Affidavit

COUNTY Rooks SEC. 1 TWP. 9S RGE. 19W ~~EW~~
Location as in quarters or footage from lines:
C NW NW SE

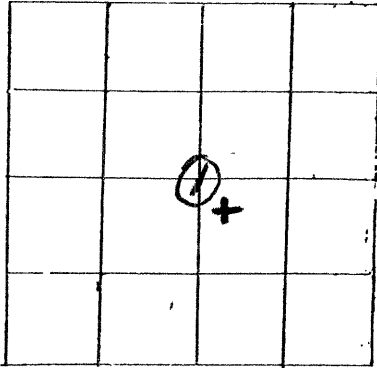

Locate Well
correctly on above
Section Platt.

Lease Owner PETRO-DYNAMICS CORPORATION
Lease Name Fleming Well No. #1
Office Address 555 N. Woodlawn, Bldg 1 - Suite 207 Wichita, KS 67208
Character of Well (Completed as Oil, Gas or Dry Hole): Dry Hole
Date Well Completed 5-3-82
Application for plugging filed 5-3-82 (Verbally)
Plugging commenced 5:00 a.m. 5-3-82
Plugging completed 6:00 a.m. 5-3-82
Reason for abandonment of well or producing formation Dry Hole

Was permission obtained from the Conservation Division or it's
Agent's before plugging was commenced? Yes

Name of Conservation Agent who supervised plugging of this well Dennis Hamil

Producing formation N/A Depth to top N/A bottom N/A T.D. N/A

Show depth and thickness of all water, oil and gas formations.

OIL, GAS OR WATER RECORDS

Casing Record

Formation	Content	From	To	Size	Put in	Pulled Out
				8 5/8" 24#	272.35'	NONE

Describe in detail the manner in which the well was plugged, indicating where the mud fluid was placed and the method or methods used in introducing it into the hold. If cement or other plugs were used, state the character of same and depth placed, from _____ feet to _____ feet for each plug set. Plugged with 135 sacks 50-50 pozmix 4% gel, 3% CaCl2

- Set 1st plug @ 800' with 70 sacks
- Set 2nd plug @ 250' with 40 sacks
- Set 3rd plug @ 40' with 10 sacks with solid bridge
- 10 sacks rathole
- 5 sacks mousehole

RECEIVED
STATE CORPORATION COMMISSION
5/17/82
MAY 17 1982
CONSERVATION DIVISION
Wichita Kansas

(If additional description is necessary, use BACK of this sheet)
Name of Plugging Contractor Allied Cementing Co., Inc.

STATE OF Kansas COUNTY OF Sedgwick, ss.
C.K. Morrison (employee of owner) or ~~(owner or operator)~~ of the
above-described well, being first duly sworn on oath, says: That I have knowledge of the
facts, statements, and matters herein contained and the log of the above-described well as
filed and that the same are true and correct. So help me God.

(Signature) C.K. Morrison
555 N. Woodlawn, Bldg. 1 - Suite 207
Wichita, KS (Address) 67208

SUBSCRIBED AND SWORN TO before me this 14 day of May, 19 82

Suzanne P. Graef
Notary Public.

My Commission expires: October 26, 1985

