

STATE OF KANSAS  
STATE CORPORATION COMMISSION

WELL PLUGGING RECORD


Give All Information Completely  
Make Required Affidavit  
Mail or Deliver Report to:  
Conservation Division  
State Corporation Commission  
800 Biting Building  
Wichita, Kansas

OR  
FORMATION PLUGGING RECORD

Strike out upper line  
when reporting plug-  
ging off formations.

..... Rooks ..... County. Sec. 9 Twp. 9 Rge. .... (E) 19 (W) 19  
Location as "NE $\frac{1}{4}$ NW $\frac{1}{4}$ SW $\frac{1}{4}$ " or footage from lines. .... NW NW NE  
Lease Owner. Westgate-Greenland Oil Company  
Lease Name. Crawford Well No. 1  
Office Address. 1022 Union National Bank Building, Wichita, Kansas  
Character of Well (completed as Oil, Gas or Dry Hole)..... dry hole  
Date well completed..... November 29, 1948 19  
Application for plugging filed..... November 29, 1948 19  
Application for plugging approved..... orally November 29, 1948 19  
Plugging commenced..... November 29, 1948 19  
Plugging completed..... November 29, 1948 19  
Reason for abandonment of well or producing formation.....

NORTH

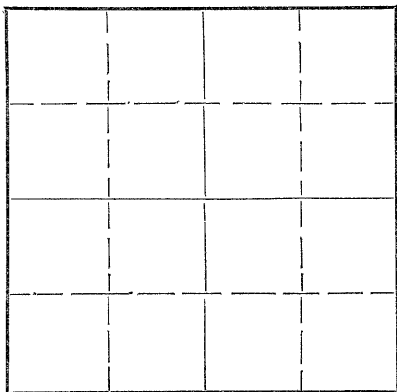

Locate well correctly on above  
Section Plat

Name of Conservation Agent who supervised plugging of this well..... M. A. Rives  
Producing formation..... Depth to top..... Bottom..... Total Depth of Well..... 3520 Feet  
Show depth and thickness of all water, oil and gas formations.

OIL, GAS OR WATER RECORDS

CASING RECORD

Formation	Content	From	To	Size	Put In	Pulled Out
<u>Surface</u>		<u>0</u>	<u>164</u>	<u>8 5/8"</u>	<u>164</u>	<u>none</u>

Describe in detail the manner in which the well was plugged, indicating where the mud fluid was placed and the method or methods used in introducing it into the hole. If cement or other plugs were used, state the character of same and depth placed, from.....feet to.....feet for each plug set.

Filled hole with heavy mud from 3520 to 164 feet  
Set Halliburton plug at 164 feet and run 20 sacks cement  
Filled hole to 20 with heavy mud and set  
Halliburton plug at 20 feet and run 10 sacks cement  
which filled hole to cellar base

**INDEXED**  
12-3-48  
DEC-3-1948


(If additional description is necessary, use BACK of this sheet)  
Correspondence regarding this well should be addressed to G. E. Bitler o/o Westgate-Greenland Oil Company  
Address. 1022 Union National Bank Building, Wichita 2, Kansas

STATE OF Kansas COUNTY OF Sedgwick, ss.  
G. E. Bitler (employee of owner) or (owner or operator) of the above-described well,  
being first duly sworn on oath, says: That I have knowledge of the facts, statements, and matters herein contained and the log of the above-described well as filed and that the same are true and correct. So help me God.

(Signature)..... G. E. Bitler  
1022 Union National Bank Building, Wichita, Kans  
(Address)

SUBSCRIBED AND SWORN to before me this 1st day of December, 19 48  
Esther Russell  
Notary Public.

My commission expires..... May 25, 1949

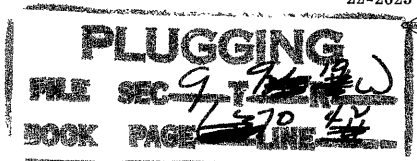

COMPANY: Westgate Greenland Oil Company  
 CONTRACTOR: Jackson Drilling Corporation  
 FARM: Crawford #1  
 LOCATION: NW NW NE Section 9-9-19W  
 Rooks County, Kansas  
 ELEVATION: 2011  
 COMMENCED: November 14, 1948  
 COMPLETED: November 29, 1948

0	to	75	Shale & sand
75	to	155	Shells & shale
155	to	173	Shale & shells
173	to	378	Shale
378	to	560	Shale & shells
560	to	590	Sand
590	to	865	Shale & shells
865	to	1175	Sand & shale
1175	to	1470	Shale & shells
1470	to	1490	Lime
1490	to	1910	Shale & shells
1910	to	2130	Shale & lime
2130	to	2140	Shale & shells
2140	to	2205	Lime
2205	to	2300	Shale & shells
2300	to	2362	Lime
2362	to	2440	Shale & shells
2440	to	2655	Lime & shale
2655	to	2700	Lime
2700	to	2870	Lime & shale
2870	to	2910	Shale
2910	to	3198	Shale & lime
3198	to	3400	Lime
3400	to	3446	Shale & lime
3446	to	3520	Lime
		3520 T.D.	

8 5/8" surface casing set at 173 feet - Cemented with 100 sacks cement

Top - Arbuckle - 3485

Dry & abandoned

### C E R T I F I C A T E

I, Clare A. Stewart, do hereby certify that the above and foregoing is a true and correct copy of log of the Crawford #1, Section 9-9-19W, Rooks County, Kansas, as reflected by files of the Jackson Drilling Corporation.

*Clare A. Stewart*  
 Clare A. Stewart

Subscribed and sworn to before me, a Notary Public, within and for Johnson County, Kansas, this 2nd day of December, 1948.

*Dorothy J. Wilson*  
 Dorothy J. Wilson

My Commission expires November 30, 1950

