


STATE OF KANSAS
STATE CORPORATION COMMISSION

WELL PLUGGING RECORD

Give All Information Completely
Make Required Affidavit
Mail or Deliver Report to:
Conservation Division
State Corporation Commission
800 Biting Building
Wichita, Kansas

Rocks _____ County, Sec. 9 Twp. 9S Rge. 19W (E) _____ (W)
Location as "NE/CNW $\frac{1}{4}$ SW $\frac{1}{4}$ " or footage from lines NE $\frac{1}{4}$ NE $\frac{1}{4}$ SW $\frac{1}{4}$
Lease Owner Birmingham-Bartlett Drilling Co.
Lease Name McClellan "A" Well No. 1
Office Address 300 Kaufman Bldg., Wichita 2, Kansas
Character of Well (completed as Oil, Gas or Dry Hole) dry hole
Date well completed 4-9- 19 52
Application for plugging filed 4-9- 19 52
Application for plugging approved 4-9- 19 52
Plugging commenced 4-9- 19 52
Plugging completed 4-9- 19 52
Reason for abandonment of well or producing formation _____

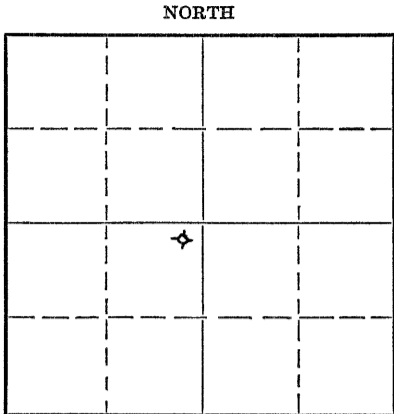

Locate well correctly on above
Section Flat

If a producing well is abandoned, date of last production _____ 19 ____
Was permission obtained from the Conservation Division or its agents before plugging was commenced? yes

Name of Conservation Agent who supervised plugging of this well Eldon Petty
Producing formation _____ Depth to top _____ Bottom _____ Total Depth of Well 3581 Feet
Show depth and thickness of all water, oil and gas formations.

OIL, GAS OR WATER RECORDS

CASING RECORD

Formation	Content	From	To	Size	Put In	Pulled Out
		150.56'	8-5/8" 2 1/2"	casing set at 148'		
				run with 125 sacks cement and 1 c.c.		

Describe in detail the manner in which the well was plugged, indicating where the mud fluid was placed and the method or methods used in introducing it into the hole. If cement or other plugs were used, state the character of same and depth placed, from _____ feet to _____ feet for each plug set.

Set bottom plug @ 145' with 15 sacks cement on top of plug
10 sacks cement and 1/2 sack hulls on top plug set at 35'
below cellar; cement mixed and poured through pipe.

4-11-52

(If additional description is necessary, use BACK of this sheet)


Correspondence regarding this well should be addressed to Birmingham-Bartlett Drilling Co.
Address 300 Kaufman Bldg.
Wichita, Kansas

STATE OF KANSAS, COUNTY OF SEDGWICK, ss.
Richard Hindery, partner of _____ (owner or operator) of the above-described well,
being first duly sworn on oath, says: That I have knowledge of the facts, statements, and matters herein contained and the log of the above-described well as filed and that the same are true and correct. So help me God.

(Signature) Richard Hindery
300 Kaufman Bldg., Wichita 2, Kansas
(Address)

SUBSCRIBED AND SWORN TO before me this 10th day of April, 19 52

My commission expires November 29, 1954 Lincoln F. Ginger Notary Public.

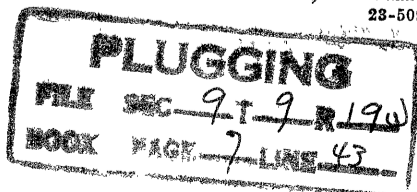

McCLELLAN "A" NO. 1

LOCATION: NE $\frac{1}{4}$ NE $\frac{1}{4}$ SW $\frac{1}{4}$ 9-98-19W
Rooks County, Kansas

OPERATOR: Birmingham-Bartlett Drilling Co.

CONTRACTOR: Birmingham-Bartlett Drilling Co.

SURFACE CASING: 8-5/8" 24# casing set at 148' with
125 sacks cement and 1 c.c.

OIL STRING: None. D & A.

SPUDDED: 3-31-52

COMPLETED: 4-9-52

LOG

(Figures indicate bottom of formation)

0 to 40	white rock
480	Shale and shells
860	Shale
1050	Shale and shells
1140	Sand
1480	Red bed and shale
1540	Anhydrite
1900	Shale and shells
2700	Shale and lime
2865	Shale and shells
3090	Shale and lime
3163	Lime
3256	Shale and lime
3309	Lime
3360	Lime and shale
3581	Lime
3581	Total Depth.

2072
-951
3023

The undersigned Richard Hindery of the Birmingham-Bartlett Drilling Co. hereby certifies that the above is a true and correct log of the formations encountered in drilling the McClellan "A" #1 well as shown on the daily drilling reports.

BIRMINGHAM-BARTLETT DRILLING CO.

BY

Richard Hindery

Subscribed and sworn before me
this 10th day of April, 1952.

Vivian L. Genger
Notary Public

My commission expires November 29, 1954.

