


Give All Information Completely
Make Required Affidavit
Mail or Deliver Report to:
Conservation Division
State Corporation Commission
211 No. Broadway
Wichita, Kansas

WELL PLUGGING RECORD

Rooks County. Sec. 9 Twp. 9S Rge. 19 (E) (W)

Location as "NE/CNW%SW%" or footage from lines NW NE NW
Lease Owner D & D Drilling Company, Inc.
Lease Name McClellan Well No. 1
Office Address 307 Schweiter Building, Wichita, Kansas
Character of Well (completed as Oil, Gas or Dry Hole) Dry Hole
Date well completed 8-25-64 19
Application for plugging filed 9-2-64 19
Application for plugging approved 8-25-64 19
Plugging commenced 8-25-64 19
Plugging completed 8-25-64 19
Reason for abandonment of well or producing formation Dry Hole

NORTH

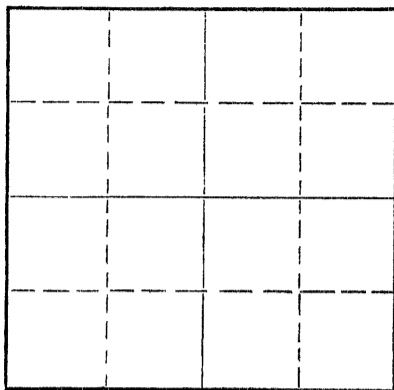

Locate well correctly on above
Section Plat

If a producing well is abandoned, date of last production -0- 19
Was permission obtained from the Conservation Division or its agents before plugging was commenced? Yes

Name of Conservation Agent who supervised plugging of this well Eldon Petty
Producing formation -0- Depth to top Bottom Total Depth of Well 3510 Feet
Show depth and thickness of all water, oil and gas formations.

OIL, GAS OR WATER RECORDS

CASING RECORD

FORMATION	CONTENT	FROM	TO	SIZE	PUT IN	PULLED OUT
Surface Hole		0	217	8 5/8	8-18-64	-0-

Describe in detail the manner in which the well was plugged, indicating where the mud fluid was placed and the method or methods used in introducing it into the hole. If cement or other plugs were used, state the character of same and depth placed, from feet to feet for each plug set.

Set Plug #1 at 540 with 20 sacks cement
Set Plug #2 at 180 with 20 sacks cement
Set Plug #3 at 40 with 10 sacks cement, 1/2 sack hulls

RECEIVED
STATE CORPORATION COMMISSION
SEP 10 1964
9-10-64
CONSERVATION DIVISION
Wichita, Kansas

(If additional description is necessary, use BACK of this sheet)

Name of Plugging Contractor D & D Drilling Company, Inc.
Address 307 Schweiter Building, Wichita, Kansas

STATE OF Kansas, COUNTY OF Sedgwick, ss.
Glenn M. Dunne, Jr. (employee of owner) or (owner or operator) of the above-described well, being first duly sworn on oath, says: That I have knowledge of the facts, statements, and matters herein contained and the log of the above-described well as filed and that the same are true and correct. So help me God.
(Signature) Glenn M. Dunne, Jr.
307 Schweiter Building, Wichita, Kansas
(Address)

SUBSCRIBED AND SWORN TO before me this 9th day of September 19 64
Colleen Chapple
Colleen Chapple Notary Public.

My commission expires 11-18-66

ROTARY DRILLING LOG

OPERATOR: D & D Drilling Co., Inc. COMMENCED: 8-18-64
 CONTRACTOR: D & D Drilling Co., Inc. COMPLETED: 8-25-64
 WELL: McClellan No. 1 ELEVATION: 2026 R.B.
 LOCATION: NW NE NW Sec. 9-9S-19W
 COUNTY: Rooks County, Kansas

FORMATIONS	Depth	Remarks
Sand & Shale	217'	Set 8 joints of Surface Casing at 217' with 190 sacks H-A-5.
Shale & Sand	1447'	
Anhy.	1491'	
Shale	2010'	
Shale & Lime	3150'	
Lime & Shale	3393'	
Lime	3510'	
Rotary Total Depth	3510'	D & A

RECEIVED
 STATE CORPORATION COMMISSION
 SEP 10 1964
 9-10-64
 CONSERVATION DIVISION
 Wichita, Kansas

A F F I D A V I T

State of Kansas)
) SS
 County of Sedgwick)

I, Glenn M. Dunne, Jr. of lawful age, being duly and solemnly sworn on oath says: I am a resident of Wichita, Sedgwick County, Kansas, and I hereby know and on oath state, the above drilling log covering the McClellan No. 1 located in NW NE NW Section 9-9S-16W, Rooks County, Kansas, is true and correct to the best of my knowledge and belief.

D & D Drilling Company, Inc.

By Glenn M. Dunne, Jr.
 Glenn M. Dunne, Jr.

Subscribed and sworn to before me this 9th day of September, 1964

My commission expires

11-18-66

Colleen Chapple
 Colleen Chapple, Notary Public