


STATE OF KANSAS
STATE CORPORATION COMMISSION

WELL PLUGGING RECORD

Give All Information Completely
Make Required Affidavit
Mail or Deliver Report to
Conservation Division
State Corporation Comm.
245 North Water
Wichita, KS 67202

Rooks County, Sec. 9 Twp. 9S Rge. 19 x&W
Location as "NE/CNW $\frac{1}{4}$ SW $\frac{1}{4}$ " or footage from lines

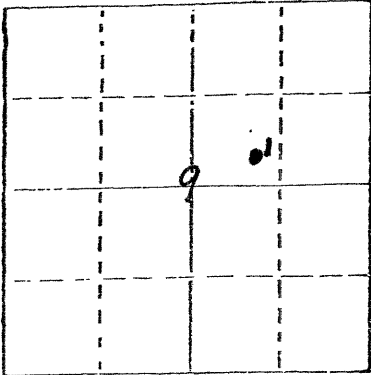

Locate well correctly on above Section Plat

SE SW NE
Lease Owner Abraxas Petroleum Corporation
Lease Name Heroneme Well No. #1
Office Address Box 17485, 1100 N.E. Loop 410, San Antonio, TX
Character of Well (Completed as Oil, Gas or Dry Hole)

Dry Hole
Date Well completed 1-8-82 19
Application for plugging filed 1-7-82 19
Application for plugging approved 1-7-82 19
Plugging commenced 1-7-82 19
Plugging completed 1-8-82 19

Reason for abandonment of well or producing formation
Commercial quantities of oil not found
If a producing well is abandoned, date of last production 19.

Was permission obtained from the Conservation Division or its agents before plugging was commenced? Yes

Name of Conservation Agent who supervised plugging of this well Carl Goodrow
Producing formation Depth to top Bottom Total Depth of Well 3545'
Show depth and thickness of all water, oil and gas formations.

OIL, GAS OR WATER RECORDS

CASING RECORD

FORMATION	CONTENT	FROM	TO	SIZE	PUT IN	PULLED OUT
				8 5/8"	262'	None

Describe in detail the manner in which the well was plugged, indicating where the mud fluid was placed and the method or methods used in introducing it into the hold. If cement or other plugs were used, state the character of same and depth placed, from feet to feet for each plug-set.

Plug @ 750' w/70 sx.
Plug @ 250' w/40 sx.
Plug @ 40' w/10 sx.

RECEIVED
STATE CORPORATION COMMISSION
1-25-82
JAN 25 1982

CONSERVATION DIVISION
Wichita, Kansas


(If additional description is necessary, use BACK of this sheet)

Name of Plugging Contractor Rains & Williamson Oil Co., Inc.

STATE OF Kansas COUNTY OF Sedgwick, ss.
Wilson Rains, President of Rains & Williamson Oil Co., Inc. (employee of owner) or (owner or operator) of the above-described well, being first duly sworn on oath, says: That I have knowledge of the facts, statements, and matters herein contained and the log of the above-described well as filed and that the same are true and correct. So help me God.

(Signature) Wilson Rains
435 Page Court, 220 W. Douglas, Wichita, Ks. 67202
(Address)

SUBSCRIBED AND SWORN TO before me this 12 day of January, 1982

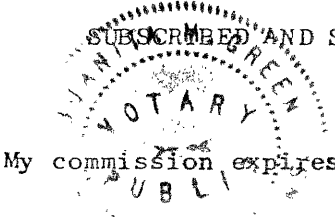

Juanita M. Green
Juanita M. Green (Notary Public)

My commission expires 10-4-83

DRILLER'S LOG

COMPANY: Abraxas Petroleum Corporation

SEC. 9 T. 9S R. 19W

WELL NAME: Heroneme #1

LOC. SE SW NE

COUNTY: Rooks

RIG NO. #4

TOTAL DEPTH 3545'

ELEVATION

COMMENCED: 12-30-81 COMPLETED: 1-8-82

CONTRACTOR: Rains & Williamson Oil Co., Inc.

CASING RECORD:

SURFACE: 8 5/8" @ 262' w/165 sx. 60/40 poz., 2% gel, 3% cc.

PRODUCTION: D&A

LOG

(Figures Indicate Bottom of Formations)

Shale & Sand	600
Shale	1975
Lime & Shale	2375
Shale & Lime	2705
Lime & Shale	2965
Shale & Lime	3085
Lime & Shale	3264
Lime	3545
<u>ROTARY TOTAL DEPTH</u>	<u>3545</u>

RECEIVED

JAN 25 1982
1-25-82
CONSERVATION DIVISION

STATE OF Kansas)
COUNTY OF Sedgwick) SS:

I, Wilson Rains, President of Rains & Williamson Oil Co., Inc.
upon oath state that the above and foregoing is a true and correct copy of the log of the
Heroneme #1 well.

Wilson Rains
Wilson Rains



Subscribed and sworn to before me this 12 day of January, 19 82.

My Appointment Expires:
10-4-83

Juanita M. Green
Juanita M. Green