


Give All Information Completely
Make Required Affidavit
Mail or Deliver Report to:
Conservation Division
State Corporation Commission
211 No. Broadway
Wichita, Kansas

WELL PLUGGING RECORD

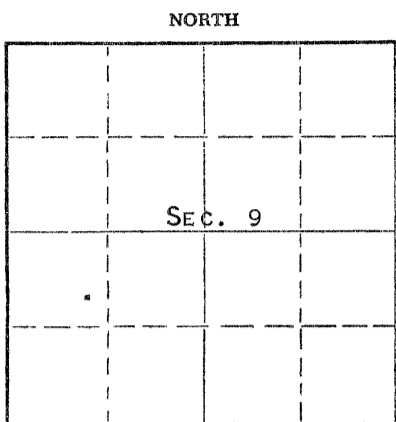

Locate well correctly on above
Section Plat

ROOKS County, Sec. 9 Twp. 9s Rge. 19 (E) (W)
Location as "NE/CNW%SW%" or footage from lines SE NW SW
Lease Owner PETROLEUM, INC.,
Lease Name McCLELLAN "C" Well No. 1
Office Address R.R. #2, GREAT BEND, KANSAS
Character of Well (completed as Oil, Gas or Dry Hole) DRY HOLE
Date well completed JAN. 1 1966
Application for plugging filed JAN. 1 1966
Application for plugging approved JAN. 1 1966
Plugging commenced JAN. 1 1966
Plugging completed JAN. 1 1966
Reason for abandonment of well or producing formation JAN. 1
NO PRODUCIBLE ZONE

If a producing well is abandoned, date of last production NONE 19
Was permission obtained from the Conservation Division or its agents before plugging was commenced? YES

Name of Conservation Agent who supervised plugging of this well GILBERT LEIKER
Producing formation _____ Depth to top _____ Bottom _____ Total Depth of Well 3547' Feet
Show depth and thickness of all water, oil and gas formations.

OIL, GAS OR WATER RECORDS

CASING RECORD

FORMATION	CONTENT	FROM	TO	SIZE	PUT IN	PULLED OUT
				8-5/8"	213'	NONE

Describe in detail the manner in which the well was plugged, indicating where the mud fluid was placed and the method or methods used in introducing it into the hole. If cement or other plugs were used, state the character of same and depth placed, from _____ feet to _____ feet for each plug set.

MUDDERED UP WITH HEAVY MUD TO 540', FOLLOWED BY WOODEN PLUG, PLACED 20 SACKS CEMENT ON TOP OF PLUG. MUDDERED UP WITH HEAVY MUD TO 200', FOLLOWED BY WOODEN PLUG, PLACED 25 SACKS CEMENT ON TOP OF PLUG. MUDDERED UP WITH HEAVY MUD TO 40' FOLLOWED BY WOODEN PLUG, PLACED 1/2 SACK HULLS AND 10 SACKS CEMENT ON TOP OF PLUG TO BASE OF WELL CELLAR.

RECEIVED
JAN 17 1966
1-17-66
CONSERVATION DIVISION

(If additional description is necessary, use BACK of this sheet)

Name of Plugging Contractor GARVEY DRILLING COMPANY
Address R.R. #2, GREAT BEND, KANSAS

STATE OF KANSAS COUNTY OF BARTON ss.
MONTE CHADD (employee of owner) or (owner or operator) of the above-described

well, being first duly sworn on oath, says: That I have knowledge of the facts, statements, and matters herein contained and the log of the above-described well as filed and that the same are true and correct. So help me God. MONTE CHADD, DIST. PROD. SUPT.

(Signature) *Monte Chadd*

SUBSCRIBED AND SWORN TO before me this 13 day of JANUARY, 1966 (Address)

My commission expires MAY 28, 1969 *Richard H. Dumble* Notary Public.

WELL LOG

COMPANY Petroleum, Inc.

SEC. 9 T. 9S R. 19W

FARM McClellan NO. C-1


LOC. SE NW SW

TOTAL DEPTH 3547'

COUNTY Rooks

COMM. 12-22-65 COMP. 1-1-66

CONTRACTOR Garvey Drilling Company

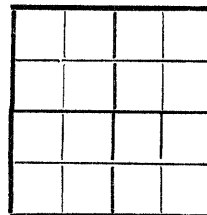

CASING 8 5/8" @ 212' w/175 sx

ELEVATION 2057' KB

PRODUCTION D & A

FIGURES INDICATE BOTTOM OF FORMATIONS

- 212' Shale
- 1270' Shale and Sand
- 1417' Shale
- 1520' Anhydrite
- 1890' Shale
- 1990' Shale and Shells
- 2695' Shale and Lime
- 2715' Lime and Shale
- 3160' Shale and Lime
- 3265' Lime and Shale
- 3285' Lime
- 3465' Lime and Shale
- 3492' Lime
- 3510' Lime and Shale
- 3527' Conglomerate
- 3547' Lime and Shale
- 3547' RTD

RECEIVED
STATE CORPORATION COMMISSION

JAN 17 1966

CONSERVATION DIVISION
TOPEKA, KANSAS

State of Kansas }
County of Barton } SS

I, Sam N. Stephens of Garvey Drilling Company

upon oath state the above and foregoing is a true and correct copy of the log of the McClellan C-1 well.

Sam N. Stephens

Subscribed and sworn to before me this 12th day of January 19 66

My Commission Expires: November 5, 1969

Richard S. Boyd
NOTARY PUBLIC