

CARD MUST BE TYPED

State of Kansas

CARD MUST BE SIGNED

NOTICE OF INTENTION TO DRILL

(see rules on reverse side)

Starting Date Feb 19 1986
month day year 320

API Number 15- 125-28,270-00-00
SE SE NE

OPERATOR: License # 5566
Name Martindale Enterprises, Inc.
Address 8222 Douglas Ave., #680
City/State/Zip Dallas, Texas 75225
Contact Person..... Bill Martindale
Phone..... 214 361-1680

app ~~SE SE NE~~ Sec. 9 Twp. 35 S, Rg. 15 West
X East
..... 3130 Ft. from South Line of Section
..... 475 Ft. from East Line of Section

(Note: Locate well on Section Plat on reverse side)

CONTRACTOR: License # 9341
Name B. R. Walker Drlg.
City/State Nowata, OK 74048

Nearest lease or unit boundary line 330 feet
County..... Montgomery
Lease Name..... Longhorn Well # 7

Well Drilled For: Well Class: Type Equipment:
X Oil SWD X Infield Mud Rotary
Gas Inj Pool Ext. X Air Rotary
OWWO Expl Wildcat Cable

Ground surface elevation feet MSL
Domestic well within 330 feet: yes X no
Municipal well within one mile: yes X no
Depth to bottom of fresh water..... 135
Depth to bottom of usable water 175
Surface pipe by Alternate: 1 2 X
Surface pipe planned to be set 100
Conductor pipe required
Projected Total Depth 1500 feet
Formation..... Mississippi

If OWWO: old well info as follows:
Operator
Well Name
Comp Date Old Total Depth.....

I certify that well will comply with K.S.A. 55-101, et seq. plus eventually plugging hole to KCC specifications.
Date .. 2/19/86 Signature of Operator or Agent Sherril Cholar Title..... as agent. POW/KCC/MS


For KCC Use:
Conductor Pipe Required feet; Minimum Surface Pipe Required feet per Alt. X (2)
This Authorization Expires 8-19-86 Approved By 2-19-86 E

Must be filed with the K.C.C. five (5) days prior to commencing well
This card void if drilling not started within six (6) months of date received by K.C.C.

Important procedures to follow:

1. Notify District office before setting surface casing.
2. Set surface casing by circulating cement to the top.
3. File completion forms ACO-1 with K.C.C. within 90 days of well completion, following instructions on ACO-1, side 1, and including copies of wireline logs.
4. Notify District office 48 hours prior to old well workover or re-entry.
5. Prior to filing Intent, prepare a proposed plugging plan in case well is D & A, then obtain approval of plan when calling district office prior to setting surface pipe.
6. Submit plugging report (CP-4) to K.C.C. after plugging is completed.
7. Obtain an approved injection docket number before disposing of salt water.
8. Notify K.C.C. within 10 days when injection commences or terminates.
9. If an alternate 2 completion, cement in the production pipe from below any usable water to surface within 120 days of spud date.

**A Regular Section of Land
1 Mile = 5,280 Ft.**

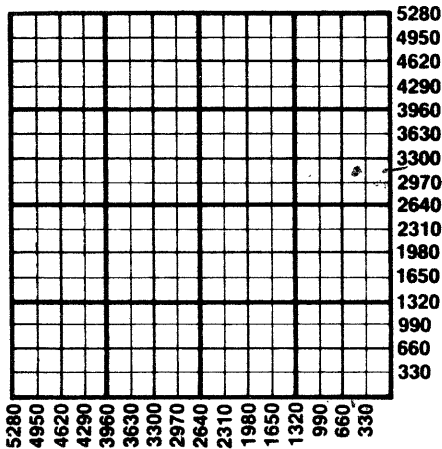

RECEIVED
STATE CORPORATION COMMISSION

FEB 19 1986 2-19-86

State Corporation Commission of Kansas
Conservation Division
200 Colorado Derby Building
Wichita, Kansas 67202
(316) 263-3238