

CARD MUST BE TYPED

State of Kansas

CARD MUST BE SIGNED

### NOTICE OF INTENTION TO DRILL

(see rules on reverse side)

Starting Date ..... 12 ..... 9 ..... 1986 .....  
month day year 11:00

API Number 15— 125-28470-0000

OPERATOR: License # ..... 5566 .....  
Name ..... Martindale Enterprises, Inc. ....  
Address ..... 8222 Douglas Ave., No. 680 .....  
City/State/Zip ..... Dallas, Texas 75225 .....  
Contact Person ..... Don DeMoss .....  
Phone ..... 214 361 1680 .....

SE. NW SE. .... Sec. 9 ... Twp. 35 S, Rg. 15 ... East  
1485 ... West  
2010 ... Ft. from South Line of Section  
... Ft. from East Line of Section

(Note: Locate well on Section Plat on reverse side)

CONTRACTOR: License # ..... 9341 .....  
Name ..... B. R. Walker .....  
City/State ..... Box 707, Nowata, OK 74048 .....

Nearest lease or unit boundary line ..... 630 ..... feet  
County ..... Montgomery .....

Well Drilled For: Well Class: Type Equipment:  
 Oil  SWD  Infield  Mud Rotary  
 Gas  Inj  Pool Ext.  Air Rotary  
 OWWO  Expl  Wildcat  Cable

Lease Name ..... Longhorn ..... Well # ..... 8 .....  
Ground surface elevation ..... na ..... feet MSL

If OWWO: old well info as follows:

Operator .....  
Well Name .....  
Comp Date ..... Old Total Depth .....

Domestic well within 330 feet:  yes  no  
Municipal well within one mile:  yes  no  
Depth to bottom of fresh water ..... 120 .....  
Depth to bottom of usable water ..... 175 .....  
Surface pipe by Alternate: 1  2   
Surface pipe planned to be set ..... 200 .....  
Conductor pipe required .....  
Projected Total Depth ..... 1450 ..... feet  
Formation ..... Mississippi .....

I certify that well will comply with K.S.A. 55-101, et seq., plus eventually plugging hole to KCC specifications.

Date .. 12/8/86 ..... Signature of Operator or Agent *Clair Durham* Title ..... as agent.

For KCC Use:


Conductor Pipe Required ..... feet; Minimum Surface Pipe Required ..... 20 feet per Alt. <sup>2</sup>  
This Authorization Expires ..... 6-8-87 ..... Approved By ..... 12-8-86 *R*

Must be filed with the K.C.C. five (5) days prior to commencing well  
 This card void if drilling not started within six (6) months of date received by K.C.C.

**Important procedures to follow:**

1. Notify District office before setting surface casing.
2. Set surface casing by circulating cement to the top.
3. File completion forms ACO-1 with K.C.C. within 90 days of well completion, following instructions on ACO-1, side 1, and including copies of wireline logs.
4. Notify District office 48 hours prior to old well workover or re-entry.
5. Prior to filing Intent, prepare a proposed plugging plan in case well is D & A, then obtain approval of plan when calling district office prior to setting surface pipe.
6. Submit plugging report (CP-4) to K.C.C. after plugging is completed.
7. Obtain an approved injection docket number before disposing of salt water.
8. Notify K.C.C. within 10 days when injection commences or terminates.

**A Regular Section of Land  
 1 Mile = 5,280 Ft.**

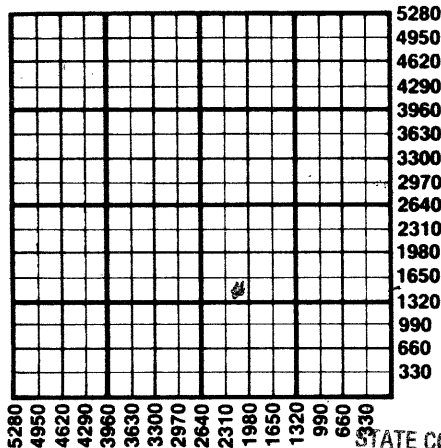

RECEIVED

STATE CORPORATION COMMISSION

9. If an alternate 2 completion, cement in the production pipe from any usable water to surface within 120 days of spud date.

12-D-86

DEC - 8 1986

CONSERVATION DIVISION  
 Wichita, Kansas

State Corporation Commission of Kansas  
 Conservation Division  
 200 Colorado Derby Building  
 Wichita, Kansas 67202  
 (316) 263-3238