

CARD MUST BE TYPED

State of Kansas

CARD MUST BE SIGNED

NOTICE OF INTENTION TO DRILL

(see rules on reverse side)

Starting Date 12 13 1986
month day year

API Number 15- 125-28,472-00-00

OPERATOR: License # 5566 App
Name .. Martindale Enterprises, Inc.
Address ... 8222 Douglas Ave., #680
City/State/Zip ... Dallas, Texas ... 75225
Contact Person ... Don DeMoss
Phone 214.361.1680

NE. SW. NE Sec...9... Twp..35. S, Rg..15...
..... 3795 Ft. from South Line of Section
..... 1835 Ft. from East Line of Section

(Note: Locate well on Section Plat on reverse side)

CONTRACTOR: License # 9341
Name .. B. R. Walker
City/State Box 707 Nowata, OK 74048

Nearest lease or unit boundary line 805 feet
County Montgomery

Lease Name Longhorn.. Well #. 9
Ground surface elevation na feet MSL

Well Drilled For: Well Class: Type Equipment:
 Oil SWD Infield Mud Rotary
 Gas Inj Pool Ext. Air Rotary
 OWWO Expl Wildcat Cable

Domestic well within 330 feet: yes no
Municipal well within one mile: yes no

If OWWO: old well info as follows:
Operator
Well Name
Comp Date Old Total Depth

Depth to bottom of fresh water 120
Depth to bottom of usable water 175

Surface pipe by Alternate: 1 _____ 2
Surface pipe planned to be set 200

Conductor pipe required
Projected Total Depth 1450 feet

Formation Mississippi

I certify that well will comply with K.S.A. 55-101, et seq., plus eventually plugging hole to KCC specifications.

Date ... 12/11/86 ... Signature of Operator or Agent *Clairie Buchanan* Title as agent

For KCC Use:


Conductor Pipe Required feet; Minimum Surface Pipe Required feet per Alt. *20*
This Authorization Expires 6-11-87 Approved By 12-11-86 *[Signature]*

Must be filed with the K.C.C. five (5) days prior to commencing well
 This card void if drilling not started within six (6) months of date received by K.C.C.

Important procedures to follow:

1. Notify District office before setting surface casing.
2. Set surface casing by circulating cement to the top.
3. File completion forms ACO-1 with K.C.C. within 90 days of well completion, following instructions on ACO-1, side 1, and including copies of wireline logs.
4. Notify District office 48 hours prior to old well workover or re-entry.
5. Prior to filing Intent, prepare a proposed plugging plan in case well is D & A, then obtain approval of plan when calling district office prior to setting surface pipe.
6. Submit plugging report (CP-4) to K.C.C. after plugging is completed.
7. Obtain an approved injection docket number before disposing of salt water.
8. Notify K.C.C. within 10 days when injection commences or terminates.

A Regular Section of Land
1 Mile = 5,280 Ft.

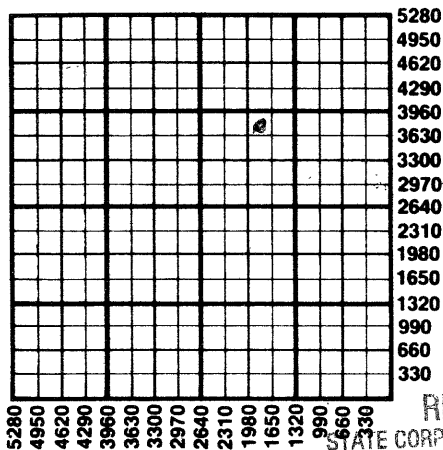

RECEIVED
 STATE CORPORATION COMMISSION

When alternate 2 completion, cement in the production pipe from below any usable water to surface within 120 days of spud date.

12-11-86

DEC 11 1986
 CONSERVATION DIVISION
 Wichita, Kansas

State Corporation Commission of Kansas
 Conservation Division
 200 Colorado Derby Building
 Wichita, Kansas 67202
 (316) 263-3238