

CARD MUST BE TYPED

State of Kansas

CARD MUST BE SIGNED

NOTICE OF INTENTION TO DRILL

(see rules on reverse side)

Starting Date Dec. 13 1986
month day year 4:00

API Number 15-125-28,473-00-00

OPERATOR: License # 5566 app.

NE. SW. NE Sec. 9 Twp. 35 S, Rg. 15 East

Name Martindale Enterprises, Inc.

3795 Ft. from South Line of Section

Address 8222 Douglas Ave., No. 680

1485 Ft. from East Line of Section

City/State/Zip Dallas, Texas 75225

(Note: Locate well on Section Plat on reverse side)

Contact Person Don DeMoss

Nearest lease or unit boundary line 1155 feet

Phone 214 361 1680

County Montgomery

CONTRACTOR: License # 9341

Lease Name Longhorn Well # 11

Name B. R. Walker

Ground surface elevation na feet MSL

City/State Box 707, Nowata, OK 74048

Domestic well within 330 feet: yes no

Well Drilled For: Well Class: Type Equipment:

Municipal well within one mile: yes no

X Oil SWD Infield X Mud Rotary

Depth to bottom of fresh water 120

Gas Inj X Pool Ext Air Rotary

Depth to bottom of usable water 175

OWWO Expl Wildcat Cable

Surface pipe by Alternate: 1 2 X

If OWWO: old well info as follows:

Surface pipe planned to be set 200

Operator

Conductor pipe required

Well Name

Projected Total Depth 1450 feet

Comp Date Old Total Depth

Formation Mississippi

I certify that well will comply with K.S.A. 55-101, et seq., plus eventually plugging hole to KCC specifications.

as agent

Date 12/11/86 Signature of Operator or Agent

Signature of Operator or Agent *Clairine D. ...*

Title

For KCC Use:

Conductor Pipe Required feet; Minimum Surface Pipe Required feet per Act. 2


This Authorization Expires 6-11-87 Approved By 12-11-86

Must be filed with the K.C.C. five (5) days prior to commencing well
 This card void if drilling not started within six (6) months of date received by K.C.C.

Important procedures to follow:

1. Notify District office before setting surface casing.
2. Set surface casing by circulating cement to the top.
3. File completion forms ACO-1 with K.C.C. within 90 days of well completion, following instructions on ACO-1, side 1, and including copies of wireline logs.
4. Notify District office 48 hours prior to old well workover or re-entry.
5. Prior to filing Intent, prepare a proposed plugging plan in case well is D & A, then obtain approval of plan when calling district office prior to setting surface pipe.
6. Submit plugging report (CP-4) to K.C.C. after plugging is completed.
7. Obtain an approved injection docket number before disposing of salt water.
8. Notify K.C.C. within 10 days when injection commences or terminates.

A Regular Section of Land
1 Mile = 5,280 Ft.

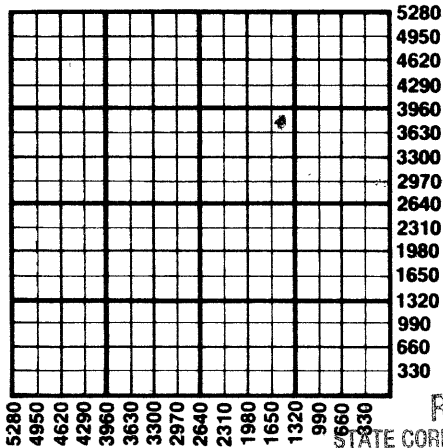

RECEIVED
 STATE CORPORATION COMMISSION

9. If an alternate 2 completion, cement in the production pipe from below any usable water to surface within 120 days of spud date.

12-11-86

DEC 11 1986
 CONSERVATION DIVISION
 Wichita, Kansas

State Corporation Commission of Kansas
 Conservation Division
 200 Colorado Derby Building
 Wichita, Kansas 67202
 (316) 263-3238