

CARD MUST BE TYPED

11-25

State of Kansas

CARD MUST BE SIGNED

NOTICE OF INTENTION TO DRILL

(see rules on reverse side)

Starting Date Dec 27, 1986
month day year

API Number 15— 125-28,475-00-00

OPERATOR: License # 5566 App C

W2. SW. SE. Sec. 9. Twp 35 ... S, Rg. ... 15. ... East

Name .. Martindale Enterprises, Inc.

..... 650 Ft. from South Line of Section

Address 8222 Douglas Ave., #680.

..... 2500 Ft. from East Line of Section

City/State/Zip .. Dallas, Texas ... 75225.

(Note: Locate well on Section Plat on reverse side)

Contact Person... Don Demoss.

Nearest lease or unit boundary line 650 feet

Phone 214-361-1680.

County..... Montgomery.

CONTRACTOR: License # 9341.

Lease Name..... Corr. Well # ... 3.

Name .. B. R. Walker.

Ground surface elevation na. feet MSL

City/State.. Box 707, Nowata, OK. 74048.

Domestic well within 330 feet: —yes no

Well Drilled For: Well Class: Type Equipment:

Municipal well within one mile: —yes no

Oil — SWD — Infield Mud Rotary

Depth to bottom of fresh water..... 120.

— Gas — Inj Pool Ext. — Air Rotary

Depth to bottom of usable water 175.

— OWWO — Expl — Wildcat — Cable

Surface pipe by Alternate: 1 2

If OWWO: old well info as follows:

Surface pipe planned to be set 200.

Operator

Conductor pipe required

Well Name

Projected Total Depth 1450. feet

Comp Date Old Total Depth.....

Formation Mississippi.

I certify that well will comply with K.S.A. 55-101, et seq., plus eventually plugging hole to KCC specifications.

Date .. 12/24/86 Signature of Operator or Agent Elaine Barham Title..... as agent

For KCC Use:

Conductor Pipe Required feet; Minimum Surface Pipe Required 175 feet per Alt. ① 2


This Authorization Expires 6-24-87 Approved By Dennis Anderson 12-24-86

Must be filed with the K.C.C. five (5) days prior to commencing well
This card void if drilling not started within six (6) months of date received by K.C.C.

Important procedures to follow:

1. Notify District office before setting surface casing.
2. Set surface casing by circulating cement to the top.
3. File completion forms ACO-1 with K.C.C. within 90 days of well completion, following instructions on ACO-1, side 1, and including copies of wireline logs.
4. Notify District office 48 hours prior to old well workover or re-entry.
5. Prior to filing Intent, prepare a proposed plugging plan in case well is D & A, then obtain approval of plan when calling district office prior to setting surface pipe.
6. Submit plugging report (CP-4) to K.C.C. after plugging is completed.
7. Obtain an approved injection docket number before disposing of salt water.
8. Notify K.C.C. within 10 days when injection commences or terminates.
9. If an alternate 2 completion, cement in the production pipe from below any usable water to surface within 120 days of spud date.

A Regular Section of Land
1 Mile = 5,280 Ft.

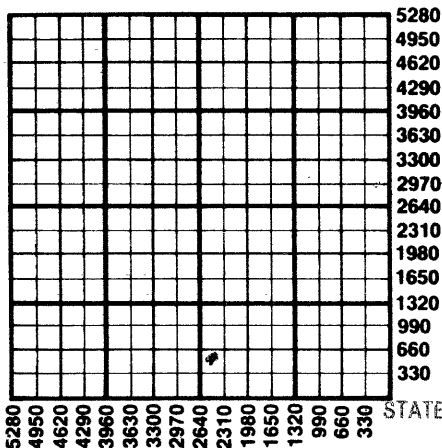

RECEIVED

STATE CORPORATION COMMISSION

DEC 24 1980

CONSERVATION DIVISION
Wichita, Kansas

12-24-80

State Corporation Commission of Kansas
Conservation Division
200 Colorado Derby Building
Wichita, Kansas 67202
(316) 263-3238