

CARD MUST BE TYPED

State of Kansas

CARD MUST BE SIGNED

NOTICE OF INTENTION TO DRILL

(see rules on reverse side)

Starting Date February 13 1987
month day year 11:54

API Number 15- 125-28,499-00-00

OPERATOR: License # 5566
Name Martindale Enterprises, Inc.
Address 8222 Douglas Ave. # 680
City/State/Zip Dallas, TX 78225
Contact Person Don DeMoss
Phone 214-361-1680

NE SE SW East
Sec. 9... Twp. 35. S, Rg. 15... West
680... Ft. from South Line of Section
2940... Ft. from East Line of Section

(Note: Locate well on Section Plat on reverse side)

CONTRACTOR: License # 9341
Name B. R. Walker Del.
City/State P.O. Box 707 Nowata, OK 74048

Nearest lease or unit boundary line 650... feet
County Montgomery

Well Drilled For: Well Class: Type Equipment:
 Oil SWD Infield Mud Rotary
 Gas Inj Pool Ext. Air Rotary
 OWWO Expl Wildcat Cable

Lease Name Corr Well # 4
Ground surface elevation ... feet MSL

If OWWO: old well info as follows:

Operator
Well Name
Comp Date Old Total Depth

Domestic well within 330 feet: yes no
Municipal well within one mile: yes no
Depth to bottom of fresh water 120
Depth to bottom of usable water 175
Surface pipe by Alternate: 1 2
Surface pipe planned to be set 200
Conductor pipe required
Projected Total Depth 1450... feet
Formation Mississippi

I certify that well will comply with K.S.A. 55-101, et seq., plus eventually plugging hole to KCC specifications.

Date 2/10/87 Signature of Operator or Agent Greg Englar Title As agent

For KCC Use:

Conductor Pipe Required ... feet; Minimum Surface Pipe Required ... feet per Alt. 20
This Authorization Expires 5-10-87 Approved By 2-10-87


Handwritten signature

Must be filed with the K.C.C. five (5) days prior to commencing well
This card void if drilling not started within six (6) months of date received by K.C.C.

Important procedures to follow:

1. Notify District office before setting surface casing.
2. Set surface casing by circulating cement to the top.
3. File completion forms ACO-1 with K.C.C. within 90 days of well completion, following instructions on ACO-1, side 1, and including copies of wireline logs.
4. Notify District office 48 hours prior to old well workover or re-entry.
5. Prior to filing Intent, prepare a proposed plugging plan in case well is D & A, then obtain approval of plan when calling district office prior to setting surface pipe.
6. Submit plugging report (CP-4) to K.C.C. after plugging is completed.
7. Obtain an approved injection docket number before disposing of salt water.
8. Notify K.C.C. within 10 days when injection commences or terminates.
9. If an alternate 2 completion, cement in the production pipe from below any usable water to surface within 120 days of spud date.

**A Regular Section of Land
1 Mile = 5,280 Ft.**

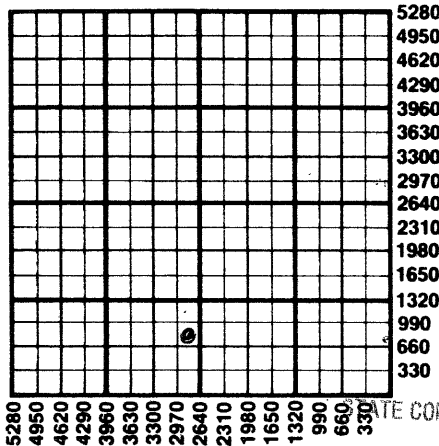

RECEIVED

STATE CORPORATION COMMISSION

FEB 10 1987

CONSERVATION DIVISION
Wichita, Kansas

0-10-87

State Corporation Commission of Kansas
Conservation Division
200 Colorado Derby Building
Wichita, Kansas 67202
(316) 263-3238