

CARD MUST BE TYPED

State of Kansas
NOTICE OF INTENTION TO DRILL
(see rules on reverse side)

CARD MUST BE SIGNED

Starting Date: ... 10 11 1984
month day year

API Number 15- 125-27,293-00-00

OPERATOR: License # ... 5566
Name ... Martindale Enterprises
Address ... 822 Douglas Avenue, Suite 360
City/State/Zip ... Dallas, Texas ... 75225
Contact Person ... Betty ... 316 289 4785
Phone ... 316 289 4785

SE NW NE Sec 10 Twp 35 S, Rge 15 East
(location) West

4281 Ft North from Southeast Corner of Section
1765 Ft West from Southeast Corner of Section
(Note: Locate well on Section Plat on reverse side)

Nearest lease or unit boundary line 875 feet.
County Montgomery

Lease Name S. Karnes Well# .. W-3

Domestic well within 330 feet : yes no
Municipal well within one mile : yes no

CONTRACTOR: License # 5831
Name ... MOKAT DRILLING
City/State ... Box 325, Tyro, Ks 67364

Depth to Bottom of fresh water 20 135 feet

Lowest usable water formation feet

Depth to Bottom of usable water 175 feet

Surface pipe by Alternate : 1 2 20

Surface pipe to be set 20 feet

Conductor pipe if any required feet

Ground surface elevation 850 feet MSL

This Authorization Expires 4-10-85

Approved By 10-10-84 [Signature]

Well Drilled For: Well Class: Type Equipment:
 Oil Swd Infield Mud Rotary
 Gas Inj Pool Ext. Air Rotary
 OWWO Expl Wildcat Cable

If OWWO: old well info as follows:

Operator
Well Name
Comp Date Old Total Depth
Projected Total Depth 1250 feet
Projected Formation at TD
Expected Producing Formations

I certify that we will comply with K.S.A. 55-101, et seq., plus eventually plugging hole to K.C.C. specifications.

Date 10/10/84 Signature of Operator or Agent

Elaine Burkan Title


as agent

RECEIVED
STATE CORPORATION COMMISSION
Must be filed with the K.C.C. five (5) days prior to commencing well
This card void if drilling not started within six (6) months of date received by K.C.C.

OCT 10 1984

CONSERVATION DIVISION
Wichita, Kansas
A Regular Section of Land
1 Mile = 5,280 Ft.

10-10-84

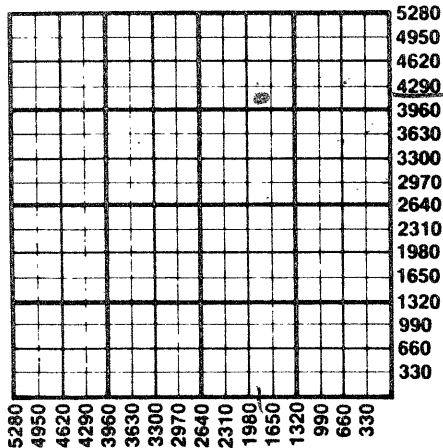

Important procedures to follow :

1. Notify District office before setting surface casing.
2. Set surface casing by circulating cement to the top.
3. File completion forms ACO-1 with K.C.C. within 90 days of well completion, following instructions on ACO-1, side 1, and including copies of wireline logs.
4. Notify District office 48 hours prior to old well workover or re-entry.
5. Prior to plugging, prepare a plugging plan, then obtain agreement from the appropriate district office for an approved plugging plan.
6. Submit plugging report (CP-4) to K.C.C. after plugging is completed.
7. Obtain an approved injection docket number before disposing of salt water.
8. Notify K.C.C. within 10 days when injection commences or terminates.
9. If an alternate 2 completion, cement in the production pipe from below any usable water to surface within 120 days of spud date.

State Corporation Commission of Kansas
Conservation Division
200 Colorado Derby Building
Wichita, Kansas 67202
(316) 263-3238