

CARD MUST BE TYPED

State of Kansas
NOTICE OF INTENTION TO DRILL

CARD MUST BE SIGNED

(see rules on reverse side)

Starting Date 11 11 85
month day year

API Number 15- 125-28,120-00-00

OPERATOR: License # 5514 App.
Name .. H. & J. Production Co., Inc.
Address .. 5501 Fox Ridge Drive
City/State/Zip ... Mission, KS ... 66202
Contact Person.. Harold E. Waeckerly
Phone..... 913. 722-5955

NW.SW.NW Sec. 10. Twp. 35. S, Rg. 15. East
..... 3470 Ft. from South Line of Section
..... 4780 Ft. from East Line of Section

(Note: Locate well on Section Plat on reverse side)

CONTRACTOR: License #
Name ... Unknown
City/State

Nearest lease or unit boundary line 840 feet
County..... Montgomery
Lease Name.. Burt-Dunbar Well # .. W-4
Ground surface elevation feet MSL

Well Drilled For: Well Class: Type Equipment:
XX Oil ___ SWD ___ Infield ___ Mud Rotary
___ Gas ___ Inj ___ Pool Ext. ___ Air Rotary
___ OWWO ___ Expl ___ Wildcat ___ Cable

Domestic well within 330 feet: ___ yes no
Municipal well within one mile: ___ yes no
Surface pipe by Alternate: 1 ~~2~~
Depth to bottom of fresh water..... 80
Depth to bottom of usable water 175
Surface pipe planned to be set 200
Projected Total Depth 1200 feet
Formation..... Bartleville

If OWWO: old well info as follows:

Operator
Well Name
Comp Date Old Total Depth.....

I certify that well will comply with K.S.A. 55-101, et seq., plus eventually plugging hole to KCC specifications.

REW/1000

_____ cementing will be done immediately upon setting production casing.

Date 11/7/85 Signature of Operator or Agent *Edwin Dunbar* Title..... as agent

For KCC Use:

Conductor Pipe Required feet; Minimum Surface Pipe Required feet per Alt. *2*

This Authorization Expires 5-7-86 Approved By 11-7-85

Must be filed with the K.C.C. five (5) days prior to commencing well
This card void if drilling not started within six (6) months of date received by K.C.C.

11-7-85

Important procedures to follow:

RECEIVED
STATE CORPORATION COMMISSION

District office before setting surface casing.


A Regular Section of Land
1 Mile = 5,280 Ft.

NOV 7 1985

2. Set surface casing by circulating cement to the top.

CONSERVATION DIVISION
Wichita, Kansas

3. File completion forms ACO-1 with K.C.C. within 90 days of well completion, following instructions on ACO-1, side 1, and including copies of wireline logs.

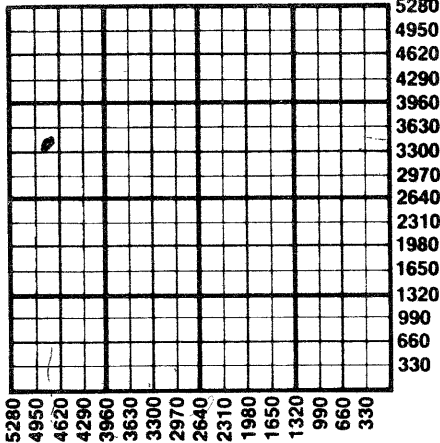

4. Notify District office 48 hours prior to old well workover or re-entry.

5. Prior to filing Intent, prepare a proposed plugging plan in case well is D & A, then obtain approval of plan when calling district office prior to setting surface pipe.

6. Submit plugging report (CP-4) to K.C.C. after plugging is completed.

7. Obtain an approved injection docket number before disposing of salt water.

8. Notify K.C.C. within 10 days when injection commences or terminates.

9. If an alternate 2 completion, cement in the production pipe from below any usable water to surface within 120 days of spud date.

State Corporation Commission of Kansas
Conservation Division
200 Colorado Derby Building
Wichita, Kansas 67202
(316) 263-3238