

CARD MUST BE TYPED

State of Kansas

CARD MUST BE SIGNED

NOTICE OF INTENTION TO DRILL

(see rules on reverse side)

Expected Spud Date..... JULY 17, 1987
month day year

API Number 15- 125-28,577-00-00

OPERATOR: License # #5514
H & J PRODUCTION CO INC.

NE SE SW Sec. 10 35 S, Rg. 15 East
1260 Twp. 2700 West

Name 4200 W. 83RD, #203

Ft. from South Line of Section
Ft. from East Line of Section

Address PRAIRIE VILLAGE, KS 66208

(Note: Locate well on Section Plat on reverse side)

City/State/Zip HAROLD WACKERLE

Nearest lease or unit boundary line 200 feet

Contact Person. (913) 648-2728

County MONTGOMERY

Phone 9722

Lease Name DUNBAR Well # 2-A

CONTRACTOR: License # G & J OIL COMPANY, INC.

Ground surface elevation feet MSL

Name P.O. BOX 188, CANEY, KANSAS 67333

Domestic well within 330 feet: yes no

City/State

Municipal well within one mile: yes no

Well Drilled For: Well Class: Type Equipment:

Depth to bottom of fresh water. 80

Oil Storage Infield Mud Rotary

Depth to bottom of usable water. 175

Gas Inj Pool Ext. Air Rotary

Surface pipe by Alternate: 1 2

OWWO Expl Wildcat Cable

Surface pipe planned to be set 20

If OWWO: old well info as follows:

Conductor pipe required 600

Operator

Projected Total Depth feet

Well Name

Formation WEISER, WAYSIDE

Comp Date Old Total Depth.....

I certify that well will comply with K.S.A. 55-101, et seq., plus eventually plugging hole to KCC specifications.

Date 7-16-87 Signature of Operator or Agent [Signature] Title AS AGENT

For KCC Use:
Conductor Pipe Required feet; Minimum Surface Pipe Required 20 feet per Alt. X2


This Authorization Expires 1-16-88 Approved By [Signature] 7-16-87

Must be filed with the K.C.C. five (5) days prior to commencing well
This card void if drilling not started within six (6) months of date received by K.C.C.

Important procedures to follow:

1. Notify District office before setting surface casing.
2. Set surface casing by circulating cement to the top.
3. File completion forms ACO-1 with K.C.C. within 120 days of well spud date, following instructions on ACO-1, side 1, and including copies of wireline logs.
4. Notify District office 48 hours prior to old well workover or re-entry.
5. Prior to filing Intent, prepare a proposed plugging plan in case well is D & A, then obtain approval of plan when calling district office prior to setting surface pipe.
6. Submit plugging report (CP-4) to K.C.C. after plugging is completed.
7. Obtain an approved injection docket number before disposing of salt water.
8. Notify K.C.C. within 10 days when injection commences or terminates.
9. If an alternate 2 completion, cement in the production pipe from below any usable water to surface within 120 days of spud date.

A Regular Section of Land
1 Mile = 5,280 Ft.

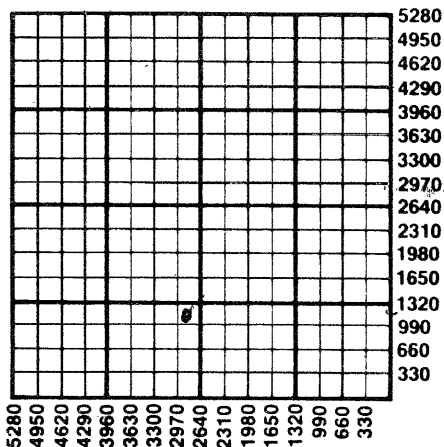

7-16-87

State Corporation Commission of Kansas
Conservation Division
200 Colorado Derby Building
Wichita, Kansas 67202-1212
(316) 263-3238

RECEIVED
STATE CORPORATION COMMISSION
MAY 16 1987
WICHITA, KANSAS