

CARD MUST BE TYPED

State of Kansas NOTICE OF INTENTION TO DRILL

CARD MUST BE SIGNED

(see rules on reverse side)

Starting Date: July 27 1984
month day year

API Number 15- 065-22,032-00-00

OPERATOR: License # 5457
Name Monsanto Oil Company
Address 3030 NW Expressway, Suite 1203
City/State/Zip Oklahoma City, Oklahoma 73112
Contact Person Robert J. Slaby
Phone (405) 947-2361

NE SE SW Sec 13 Twp 9 S, Rge 21
(location) East West
990 Ft North from Southeast Corner of Section
2970 Ft West from Southeast Corner of Section
(Note: Locate well on Section Plat on reverse side)

CONTRACTOR: License #
Name Pending
City/State

Nearest lease or unit boundary line 990 feet.
County Graham
Lease Name Balthazor Well# 9

Well Drilled For: Well Class: Type Equipment:
 Oil Swd Infield Mud Rotary
 Gas Inj Pool Ext. Air Rotary
 OWWO Expl Wildcat Cable

Domestic well within 330 feet: yes no
Municipal well within one mile: yes no

If OWWO: old well info as follows:
Operator N/A
Well Name
Comp Date Old Total Depth
Projected Total Depth 4000' feet
Projected Formation at TD Arbuckle
Expected Producing Formations Arbuckle/Lansing-KC

Depth to Bottom of fresh water 260 feet
Lowest usable water formation Dakota
Depth to Bottom of usable water 900 feet
Surface pipe by Alternate: 1 2
Surface pipe to be set 300 feet
Conductor pipe if any required NA feet
Ground surface elevation 2185 feet MSL
This Authorization Expires 1/26/85
Approved By 7/26/84 [Signature]

I certify that we will comply with K.S.A. 55-101, et seq., plus eventually plugging hole to K.C.C. specifications.


Date 7-20-84 Signature of Operator or Agent Paul Harrison Title Regional Production Manager

MHC/KOHE 7/26/84

Must be filed with the K.C.C. five (5) days prior to commencing well
 This card void if drilling not started within six (6) months of date received by K.C.C.

RECEIVED
 JUL 26 1984
 7-26-84
 STATE CORPORATION COMMISSION
 CONSERVATION DIVISION
 Wichita, Kansas

A Regular Section of Land
 1 Mile = 5,280 Ft.

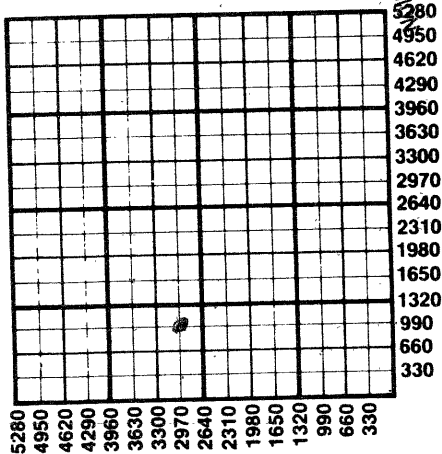

Important procedures to follow:

1. Notify District office before setting surface casing.
2. Set surface casing by circulating cement to the top.
3. File completion forms ACO-1 with K.C.C. within 90 days of well completion, following instructions on ACO-1, side 1, and including copies of wireline logs.
4. Notify District office 48 hours prior to old well workover or re-entry.
5. Prior to plugging, prepare a plugging plan, then obtain agreement from the appropriate district office for an approved plugging plan.
6. Submit plugging report (CP-4) to K.C.C. after plugging is completed.
7. Obtain an approved injection docket number before disposing of salt water.
8. Notify K.C.C. within 10 days when injection commences or terminates.
9. If an alternate 2 completion, cement in the production pipe from below any usable water to surface within 120 days of spud date.

State Corporation Commission of Kansas
 Conservation Division
 200 Colorado Derby Building
 Wichita, Kansas 67202
 (316) 263-3238