

CARD MUST BE TYPED

State of Kansas

CARD MUST BE SIGNED

NOTICE OF INTENTION TO DRILL

(see rules on reverse side)

Expected Spud Date. June 21, 1988
month day year

API Number 15-065-22,467-00-00

OPERATOR: License # 5285
Name The Dane G. Hansen Trust
Address P. O. Box 187
City/State/Zip Logan, Kansas 67646
Contact Person Dane G. Bales
Phone 913-689-4816

NW NE NW Sec. 13 Twp. 9S S, Rg. 21 East
4950 West
3630 Ft. from South Line of Section
Ft. from East Line of Section

(Note: Locate well on Section Plat on reverse side)

CONTRACTOR: License # 5783
Name Galloway Drilling Co., Inc.
City/State Wichita, Kansas 67202

Nearest lease or unit boundary line 330 feet
County Graham
Lease Name Eichman Well # 14

Well Drilled For: Well Class: Type Equipment:
X Oil Storage X Infield X Mud Rotary
Gas Inj Pool Ext Air Rotary
OWWO Expl Wildcat Cable

Ground surface elevation feet MSL
Domestic well within 330 feet: yes X no
Municipal well within one mile: yes X no
Depth to bottom of fresh water 200
Depth to bottom of usable water 1000

If OWWO: old well info as follows:

Surface pipe by Alternate: 1 2X
Surface pipe planned to be set 225
Conductor pipe required
Projected Total Depth 3700 feet
Formation Arbuckle

Operator
Well Name
Comp Date Old Total Depth

I certify that well will comply with K.S.A. 55-101, et seq., plus eventually plugging hole to KCC specifications.

Date 6/15/88 Signature of Operator or Agent Title Manager

For KCC Use:

Conductor Pipe Required feet; Minimum Surface Pipe Required 200 feet per Alt.
This Authorization Expires 12-16-88 Approved By 6-16-88


EFFECTIVE DATE: 6-21-88

Must be filed with the K.C.C. five (5) days prior to commencing well  
This card void if drilling not started within six (6) months of date received by K.C.C.

### Important procedures to follow:

1. Notify District office before setting surface casing.
2. Set surface casing by circulating cement to the top.
3. File completion forms ACO-1 with K.C.C. within 120 days of well spud date, following instructions on ACO-1, side 1, and including copies of wireline logs.
4. Notify District office 48 hours prior to old well workover or re-entry.
5. Prior to filing Intent, prepare a proposed plugging plan in case well is D & A, then obtain approval of plan when calling district office prior to setting surface pipe.
6. Submit plugging report (CP-4) to K.C.C. after plugging is completed.
7. Obtain an approved injection docket number before disposing of salt water.
8. Notify K.C.C. within 10 days when injection commences or terminates.
9. If an alternate 2 completion, cement in the production pipe from below any usable water to surface within 120 days of spud date.

### A Regular Section of Land 1 Mile = 5,280 Ft.

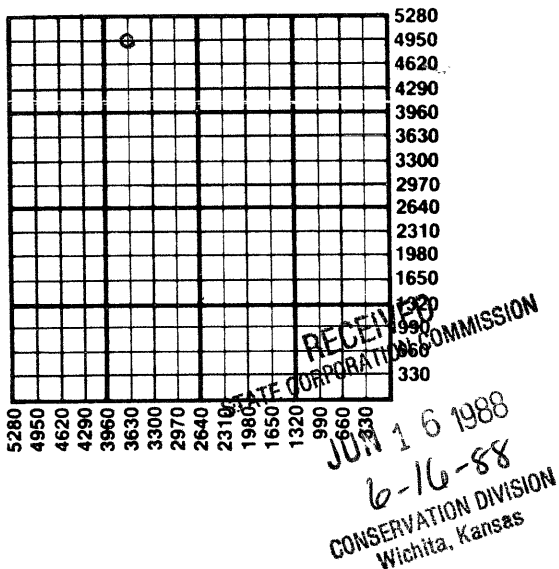

State Corporation Commission of Kansas  
Conservation Division  
200 Colorado Derby Building  
Wichita, Kansas 67202-1212  
(316) 263-3238