

CARD MUST BE TYPED

NOTICE OF INTENTION TO DRILL
(see rules on reverse side)

CARD MUST BE SIGNED

Starting Date: 8 3 1985
month day year

API Number IS- 125-27942-00-00

OPERATOR: License # 5566
 Name Martindale Enterprises, Inc.
 Address 8222 Douglas Ave., #680
 City/State/Zip Dallas, TX 75225
 Contact Person Bill Martindale
 Phone 214 361 1680

App. . NW . NW . NW . . . Sec . 9 . Twp . 35 . S, Rge . 15 . ☒ East
☐ West
(location)
5080 Ft North from Southeast Corner of Section
5080 Ft West from Southeast Corner of Section
(Note: Locate well on Section Plat on reverse side)

CONTRACTOR: License # 9341
Name B. R. Walker Drlg.
City/State Nowata, OK 74048

Nearest lease or unit boundary line 200 feet.
County Montgomery
Lease Name ... Arnold, Bachman Well# W-6
Domestic well within 330 feet : ☐ yes ☒ no
Municipal well within one mile : ☐ yes ☒ no

Well Drilled For:	Well Class:	Type Equipment:
☐ Oil ☐ Swd	☒ Infield	☐ Mud Rotary
☐ Gas ☐ Inj	☐ Pool Ext.	☒ Air Rotary
☐ OWWO ☐ Expl	☐ Wildcat	☐ Cable
If OWWO: old well info as follows: Wtr. Sup		

Depth to Bottom of fresh water 135 feet
Lowest usable water formation
Depth to Bottom of usable water 175 feet
Surface pipe by Alternate: 1 ☐ 2 ☒
Surface pipe to be set 20 feet
Conductor pipe if any required feet
Ground surface elevation feet MSL
This Authorization Expires 2-2-86
Approved By 8-2-85

If OWWO: old well info as follows: Wtr. Sup

Operator

Well Name

Comp Date Old Total Depth
1450

Projected Total Depth feet

Projected Formation at TD

Expected Producing Formations

I certify that we will comply with K.S.A. 55-101, et seq., plus eventually plugging hole to K.C.C. specifications.

Date 8/2/85 Signature of Operator or Agent

Elaine Barkorn Title as Agent

REN FOR KONE

Must be filed with the K.C.C. five (5) days prior to commencing well
This card void if drilling not started within six (6) months of date received by K.C.C.

RECEIVED
STATE CORPORATION COMMISSION


82-85

AUG 2 1985

Important procedures to follow:

CONSERVATION DIVISION
Wichita, Kansas

A Regular Section of Land
1 Mile = 5,280 Ft.

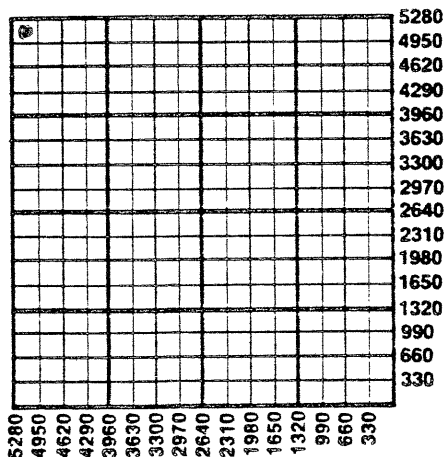

1. Notify District office before setting surface casing.
2. Set surface casing by circulating cement to the top.
3. File completion forms ACO-1 with K.C.C. within 90 days of well completion, following instructions on ACO-1, side 1, and including copies of wireline logs.
4. Notify District office 48 hours prior to old well workover or re-entry.
5. Prior to plugging, prepare a plugging plan, then obtain agreement from the appropriate district office for an approved plugging plan.
6. Submit plugging report (CP-4) to K.C.C. after plugging is completed.
7. Obtain an approved injection docket number before disposing of salt water.
8. Notify K.C.C. within 10 days when injection commences or terminates.
9. If an alternate 2 completion, cement in the production pipe from below any usable water to surface within 120 days of spud date.

State Corporation Commission of Kansas
Conservation Division
200 Colorado Derby Building
Wichita, Kansas 67202
(316) 263-3238