

CARD MUST BE TYPED

State of Kansas

CARD MUST BE SIGNED

NOTICE OF INTENTION TO DRILL

(see rules on reverse side)

CORRECTION

10-17-85

Starting Date ¹⁰.....¹⁵.....1985
month day year

API Number 15-125-28,027-00-00

CORRECTION East

OPERATOR: License #9342.....
NameJerry D. Barton.....
AddressRt. 1 Box 294.....
City/State/Zip ..Independence, KS...67301.....
Contact Person, Jerry Barton.....
Phone.....(316) 289-4363.....

App. SE. NE. SW Sec. ...9. Twp. 35. S, Rg. 15... West
* 1.650..... Ft. from South Line of Section
* 2970..... Ft. from East Line of Section

(Note: Locate well on Section Plat on reverse side)

CONTRACTOR: License # 4.2.42.....
NameJohn Masek Drilling, Inc.....
City/State.....Tyro, KS...67364.....

Nearest lease or unit boundary line ...330..... feet
County.....Montgomery.....

Well Drilled For: Well Class: Type Equipment:
 Oil SWD Infield Mud Rotary
 Gas Inj Pool Ext. Air Rotary
 OWWO Expl Wildcat Cable

Lease Name.....Bachman..... Well #.....W2.....
Ground surface elevationna..... feet MSL

If OWWO: old well info as follows:
Operator
Well Name
Comp Date..... Old Total Depth.....

Domestic well within 330 feet: yes no
Municipal well within one mile: yes no

Surface pipe by Alternate: 2

I certify that well will comply with K.S.A. 55-101, et seq., plus eventually plugging hole to KCC specifications.
_____ cementing will be done immediately upon setting production casing.

Depth to bottom of fresh water.....100.....

Depth to bottom of usable water175.....

Surface pipe planned to be set250.....

Projected Total Depth1500..... feet

Formation.....Mississippi.....

Date ...10/15/85... Signature of Operator or Agent *John Masek* Title As Agent

For KCC Use:
Conductor Pipe Required feet; Minimum Surface Pipe Required feet per Alt. 1 2

This Authorization Expires.....3-18-86..... Approved By9-18-85.....

Must be filed with the K.C.C. five (5) days prior to commencing well
This card void if drilling not started within six (6) months of date received by K.C.C.


10-15-85

RECEIVED
STATE CORPORATION COMMISSION

A Regular Section of Land
1 Mile = 5,280 Ft.

OCT 15 1985

CONSERVATION DIVISION
Wichita, Kansas

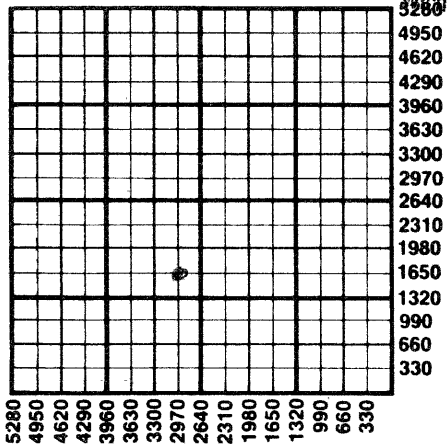

Important procedures to follow:

1. Notify District office before setting surface casing.
2. Set surface casing by circulating cement to the top.
3. File completion forms ACO-1 with K.C.C. within 90 days of well completion, following instructions on ACO-1, side 1, and including copies of wireline logs.
4. Notify District office 48 hours prior to old well workover or re-entry.
5. Prior to filing Intent, prepare a proposed plugging plan in case well is D & A, then obtain approval of plan when calling district office prior to setting surface pipe.
6. Submit plugging report (CP-4) to K.C.C. after plugging is completed.
7. Obtain an approved injection docket number before disposing of salt water.
8. Notify K.C.C. within 10 days when injection commences or terminates.
9. If an alternate 2 completion, cement in the production pipe from below any usable water to surface within 120 days of spud date.

State Corporation Commission of Kansas
Conservation Division
200 Colorado Derby Building
Wichita, Kansas 67202
(316) 263-3238