

CARD MUST BE TYPED

State of Kansas

CARD MUST BE SIGNED

NOTICE OF INTENTION TO DRILL

(see rules on reverse side)

Starting Date Sept. 26, 1985
month day year 10:25OPERATOR: License # 9342
Name Jerry D. Barton
Address R. R. 1, Box 294
City/State/Zip Independence, KS. 67301
Contact Person Jerry Barton
Phone 316.289.4363CONTRACTOR: License # 4242
Name John Masek Drilling, Inc.
City/State Tyro, KS. 67364Well Drilled For: Well Class: Type Equipment:
☒ Oil ☐ SWD ☒ Infield ☐ Mud Rotary
☐ Gas ☐ Inj ☐ Pool Ext. ☒ Air Rotary
☐ OWWO ☐ Expl ☐ Wildcat ☐ Cable

If OWWO: old well info as follows:

Operator
Well Name
Comp Date Old Total Depth

I certify that well will comply with K.S.A. 55-101, et seq., plus eventually plugging hole to KCC specifications.

_____ cementing will be done immediately upon setting production casing.

Date .. 9/26/85 Signature of Operator or Agent Title

For KCC Use:

Conductor Pipe Required feet; Minimum Surface Pipe Required feet per Alt 1 2

This Authorization Expires 3-26-86 Approved By 9-26-85 Re

API Number 15— 125-28,040-00-00
SE SW NW
Sec. 9 Twp. 35 S, Rg. 15
..... 2970 Ft. from South Line of Section
..... 4220 4510 Ft. from East Line of Section

(Note: Locate well on Section Plat on reverse side)


Nearest lease or unit boundary line 330 feet
County Montgomery
Lease Name Bachman Well # W-3
Ground surface elevation feet MSL
Domestic well within 330 feet: yes ☒ no
Municipal well within one mile: yes ☒ no
Surface pipe by Alternate: 1 ☒ 2 ☒
Depth to bottom of fresh water 100
Depth to bottom of usable water 175
Surface pipe planned to be set 250
Projected Total Depth 1500 feet
Formation MississippiREAR DATE
as agent

RECEIVED
STATE CORPORATION COMMISSION

Notify District office before setting surface casing.

SEP 26 1985

CONSERVATION DIVISION
Wichita, Kansas
5280

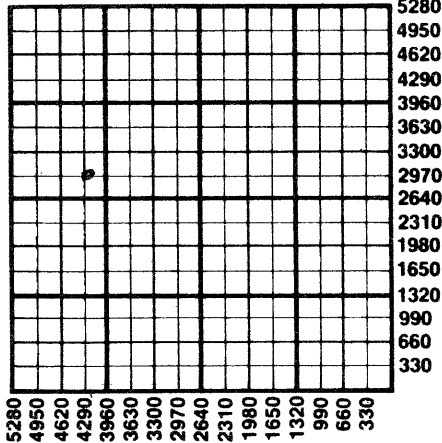

- State Corporation Commission of Kansas
Conservation Division
200 Colorado Derby Building
Wichita, Kansas 67202
(316) 263-3238**