

STATE OF KANSAS
STATE CORPORATION COMMISSION
CONSERVATION DIVISION
200 Colcrado Derby Building
Wichita, Kansas 67202

FORM CP-1
Rev. 2/89

WELL PLUGGING APPLICATION FORM
(File One Copy)

15-163-19307-00-01

API NUMBER Completed 07/13/50 (of this well).

(This must be listed; if no API# was issued, please note drilling completion date.)

WELL OWNER/OPERATOR Phillips Petroleum Company OPERATOR'S LICENSE NO. 5229

ADDRESS Route 3, Box 20-A, Great Bend, KS 67530 PHONE # (316) 793-8421

LEASE (FARM) Chandler SWD WELL NO. D01 WELL LOCATION SE SE SW COUNTY Rooks

SEC. 11 TWP. 9S RGE. 19 (E) or (W) TOTAL DEPTH 3908' PLUG BACK TD 3908'

Check One:

OIL WELL ☐ GAS WELL ☐ D & A ☐ SWD or INJ WELL ☒ DOCKET NO. 39,790-C

SURFACE CASING SIZE 10 3/4" SET AT 224' CEMENTED WITH circulated SACKS

CASING SIZE 7" SET AT 3624' CEMENTED WITH 1400 SACKS

PERFORATED AT Open Hole 3624-3908'

CONDITION OF WELL: GOOD ☒ POOR ☐ CASING LEAK ☐ JUNK IN HOLE ☐

PROPOSED METHOD OF PLUGGING We will plug well according to the rules and regulations
of the State of Kansas

(If additional space is needed use back of form.)

IS WELL LOG ATTACHED TO THIS APPLICATION AS REQUIRED? Yes IS ACO-1 FILED? ☐
(If not explain.)

DATE AND HOUR PLUGGING IS DESIRED TO BEGIN As soon as possible

PLUGGING OF THIS WELL WILL BE DONE IN ACCORDANCE WITH K.S.A. 55-101 et. seq. AND THE
RULES AND REGULATIONS OF THE STATE CORPORATION COMMISSION.

NAME OF REPRESENTATIVE AUTHORIZED TO BE IN CHARGE OF PLUGGING OPERATIONS:

Phillips Petroleum Company PHONE # (316) 793-8421

ADDRESS Route 3, Box 20-A, Great Bend, Kansas 67530

PLUGGING CONTRACTOR Phillips Petroleum Company LICENSE NO. 5229

ADDRESS Route 3, Box 20-A, Great Bend, Kansas 67530 PHONE # (316) 793-8421

PAYMENT OF THE PLUGGING FEE (K.A.R. 82-3-118) WILL BE GUARANTEED BY OPERATOR OR AGENT.

SIGNED:


JW Taylor
(Operator or Agent)

DATE:

2/6/91

(4)

GL	<u>2026</u>
KB	<u>2031</u>
PBTD	<u> </u>
TD	<u>3908</u>

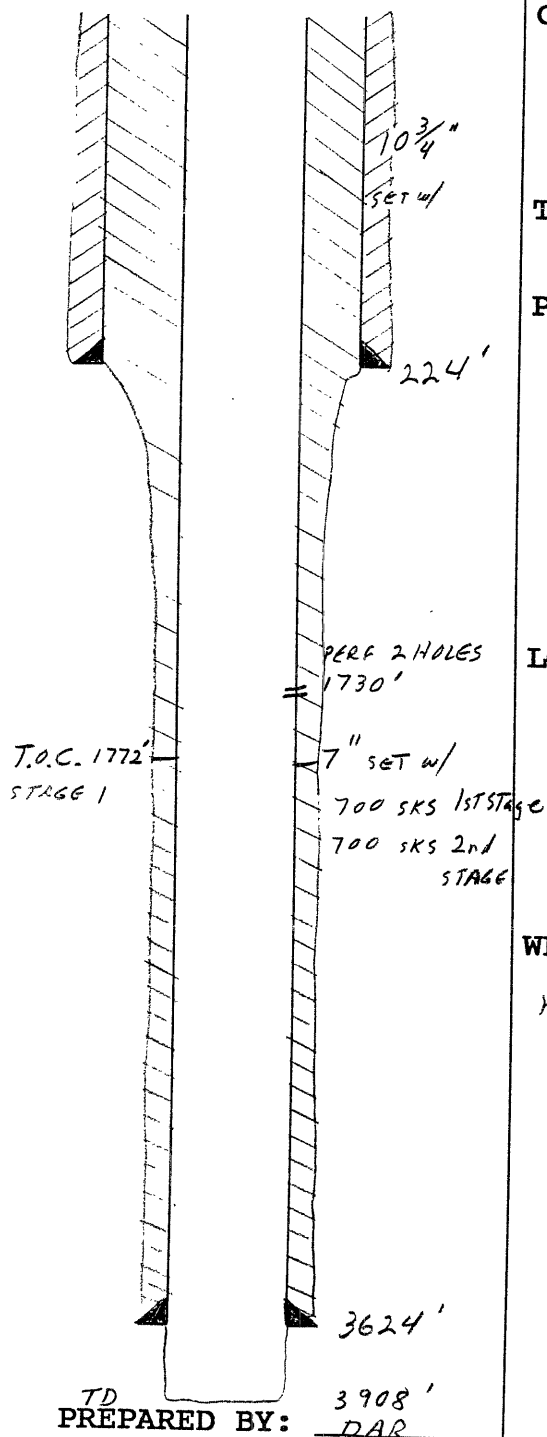

TD 3908'
PREPARED BY: DAR

DATE: 6/13/96

WELL LOCATION	CHANDLER SWD SYSTEM DOI	STATUS	SD DISPOSAL
	SE SE SW		
	SEC 11-T9S-R19W	CHANDLER POOL	
	ROOKS COUNTY, KS		
SPUD	3-18-50	REENTRY OF OLD P&A HOLE	
COMPLETED	7-13-50		
IP			

CASING	OD	WT	CEMENT ~~GRADE~~	FROM	TO
	10 3/4"			224	SURF.
	7"	24#	700 SKS 1st stage	3624	0
			700 SKS 2nd stage	CIRC TO	SURFACE.
TUBING					

<u>PERFS.</u>	<u>ZONE</u>	<u>TYPE</u>	<u>INTERVAL</u>	<u>SFP</u>
	<u>ARBuckle</u>	<u>OPEN HOLE</u>	<u>3624-3908'</u>	
	<u>* GRANITE WASH.</u>			
	<u>SHUT DOWN RS NOT NEEDED - MIT</u>		<u>2/4/86</u>	

[illegible][illegible]

Formation Record

Lease

Thyfault

(Chandler Pool S.W.D. System)

Well No.

1

FROM	TO	Formation	REMARKS
0	45	Surface Soil	
45	230	Shale	
230	733	Sand and Shale	
733	1050	Shale and Shells	
1050	1245	Sand Lime	
1245	1350	Sandy Shale	
1350	1428	Shale	
1428	1460	Anhydrite	
1460	1800	Shale	
1800	1915	Shale and Shells	
1915	2175	Lime and Shale	
2175	2245	Shale	
2245	2285	Lime	
2285	2385	Lime and Shale	
2385	2515	Shale and Shells	
2515	2680	Lime and Shale	
2680	2825	Shale and Shells	
2825	2975	Shale, Lime and Shells	
2975	3097	Lime and Shale	
3097	3513	Lime	
3513	3535	Lime - Hard - Rough	
3535	3539	Lime	
3539	3559	Lime - Hard - Rough	
3559	3579	Lime - Pyrite and Chert	
3579	3612	Sandy Lime	
3612	3643	Sand, Lime and Pyrite	
3643	3673	Lime - Pyrite	
3673	3790	Sandy Lime	
3790	3848	Lime and Chert	
3848	3881	Lime	
3881	3890	Lime and Sand	
3890	3901	Chert	
3901	3908	Granite Wash	

Top Granite Wash @ 3885'.

FFR 8 1991

Joan Finney
Governor

Keith R. Henley
Chairman

Rich Kowalewski
Commissioner

Jack Shriver
Commissioner

Judith McConnell
Executive Director



Kansas Corporation Commission

NOTICE OF RECEIPT OF WELL PLUGGING APPLICATION

February 11, 1991

Phillips Petroleum Co.
Route 3, Box 20-A
Great Bend, KS 67530

Chandler SWD #D01
SE SE SW 11-09-19W
Rooks County, KS

Gentlemen:

This letter is to notify you that the Conservation Division is in receipt of your plugging proposal, form CP-1, for the above-captioned well.

Your CP-1 has been reviewed by the Conservation Division central office for completeness and to verify license numbers. The plugging proposal will now be forwarded to the district office listed below for review of your proposed method of plugging. Please contact the district office for approval of your proposed plugging method at least five (5) days before plugging the well, pursuant to K.A.R. 82-3-113(b). Failure to do so is punishable by an administrative penalty of up to \$1000.

It has recently come to my attention that the form CP-1 has been filed by operators other than the owner or operator of the well and without the consent of the owner or operator. The Conservation Division's review of form CP-1, either in the central or district office, does not include an inquiry into well ownership or the filing operator's legal right to plug the well.

This notice in no way constitutes authorization to plug the above-captioned well by persons not having legal rights of ownership or interest in the well. This notice is void after ninety (90) days from the above date.

Sincerely,

A handwritten signature in dark ink, appearing to read "David P. Williams".

David P. Williams
Production Supervisor

District: #4, 2301 E. 13th
Hays, KS 67601
(913) 628 - 1200

Conservation Division
Shari Feist Albrecht
Director

200 Colorado Derby Bldg.
202 W. 1st Street

Wichita, Kansas 67202-1286
Telephone (316) 263-3238