

For KCC Use:
Effective Date: 12-11-07
District # 3
SGA? ☐ Yes ☒ No

KANSAS CORPORATION COMMISSION
OIL & GAS CONSERVATION DIVISION

NOTICE OF INTENT TO DRILL

Must be approved by KCC five (5) days prior to commencing well

RECEIVED
KANSAS CORPORATION COMMISSION
OIL & GAS CONSERVATION DIVISION
WICHITA, KS
DEC 06 2007

Form C-1

October 2007

Form must be Typed

Form must be Signed

All blanks must be Filled

Expected Spud Date: November 10 2007
month day year

OPERATOR: License# 33181
Name: Jordan Wilson
Address 1: 5994 Palm RD.
Address 2: _____
City: Neosho State: MO. Zip: 64850
Contact Person: Jordan Wilson
Phone: 417-455-3578

CONTRACTOR: License# 5989
Name: Finney Drilling CO.

Well Drilled For: ☒ Oil ☐ Enh Rec ☒ Gas ☐ Storage ☐ Disposal ☐ Seismic; # of Holes ☐ Other: _____
Well Class: ☒ Infield ☐ Pool Ext. ☐ Wildcat ☐ Other: _____
Type Equipment: ☐ Mud Rotary ☒ Air Rotary ☐ Cable

☐ If OWWO: old well information as follows:

Operator: _____
Well Name: _____
Original Completion Date: _____ Original Total Depth: _____

Directional, Deviated or Horizontal wellbore? ☐ Yes ☒ No
If Yes, true vertical depth: _____
Bottom Hole Location: _____
KCC DKT #: _____

Spot Description: SW-NW-NW
NE-SW NW NW NW Sec. 27 Twp. 33 S. R. 15 ☒ E ☐ W
(0000) 500 900 feet from ☒ N / ☐ S Line of Section
400 400 feet from ☐ E / ☒ W Line of Section
Is SECTION: ☒ Regular ☐ Irregular?

(Note: Locate well on the Section Plat on reverse side)

County: Montgomery
Lease Name: Clarkson 41 Well #: 7
Field Name: Jefferson-Sycamore

Is this a Prorated / Spaced Field? ☐ Yes ☒ No

Target Formation(s): WAYSIDE

Nearest Lease or unit boundary line (in footage): 500 feet

Ground Surface Elevation: est 840 topo _____ feet MSL

Water well within one-quarter mile: ☐ Yes ☒ No

Public water supply well within one mile: ☐ Yes ☒ No

Depth to bottom of fresh water: 150

Depth to bottom of usable water: 175

Surface Pipe by Alternate: ☒ I ☐ II

Length of Surface Pipe Planned to be set: 50 feet

Length of Conductor Pipe (if any): N/A

Projected Total Depth: 650

Formation at Total Depth: wayside

Water Source for Drilling Operations:

☐ Well ☐ Farm Pond ☐ Other: Tank Truck

DWR Permit #: _____

(Note: Apply for Permit with DWR ☒)

Will Cores be taken? ☐ Yes ☒ No

If Yes, proposed zone: _____

AFFIDAVIT

The undersigned hereby affirms that the drilling, completion and eventual plugging of this well will comply with K.S.A. 55 et. seq.

It is agreed that the following minimum requirements will be met:

1. Notify the appropriate district office **prior** to spudding of well;
2. A copy of the approved notice of intent to drill **shall be** posted on each drilling rig;
3. The minimum amount of surface pipe as specified below **shall be set** by circulating cement to the top; in all cases surface pipe **shall be set** through all unconsolidated materials plus a minimum of 20 feet into the underlying formation.
4. If the well is dry hole, an agreement between the operator and the district office on plug length and placement is necessary **prior to plugging**;
5. The appropriate district office will be notified before well is either plugged or production casing is cemented in;
6. If an ALTERNATE II COMPLETION, production pipe shall be cemented from below any usable water to surface within **120 DAYS** of spud date.
Or pursuant to Appendix "B" - Eastern Kansas surface casing order #133,891-C, which applies to the KCC District 3 area, alternate II cementing must be completed within 30 days of the spud date or the well shall be plugged. **In all cases, NOTIFY district office** prior to any cementing.

I hereby certify that the statements made herein are true and correct to the best of my knowledge and belief.

Date: 11-1-07 Signature of Operator or Agent: Jordan Wilson Title: President

For KCC Use ONLY

API # 15 - 125-31487-0000
Conductor pipe required None feet
Minimum surface pipe required 20 feet per ALT. ☐ I ☒ II
Approved by FW 12-6-07
This authorization expires: 12-6-08
(This authorization void if drilling not started within 12 months of approval date.)
Spud date: _____ Agent: _____

Remember to:

- File Drill Pit Application (form CDP-1) with Intent to Drill;
- File Completion Form ACO-1 within 120 days of spud date;
- File acreage attribution plat according to field proration orders;
- Notify appropriate district office 48 hours prior to workover or re-entry;
- Submit plugging report (CP-4) after plugging is completed (within 60 days);
- Obtain written approval before disposing or injecting salt water.
- If this permit has expired (See: authorized expiration date) please check the box below and return to the address below.

☐ Well Not Drilled - Permit Expired Date: _____
Signature of Operator or Agent: _____

Mail to: KCC - Conservation Division, 130 S. Market - Room 2078, Wichita, Kansas 67202

27 33 15 ☒ E ☐ W

IN ALL CASES PLOT THE INTENDED WELL ON THE PLAT BELOW

Plat of acreage attributable to a well in a prorated or spaced field

If the intended well is in a prorated or spaced field, please fully complete this side of the form. If the intended well is in a prorated or spaced field complete the plat below showing that the well will be properly located in relationship to other wells producing from the common source of supply. Please show all the wells and within 1 mile of the boundaries of the proposed acreage attribution unit for gas wells and within 1/2 mile of the boundaries of the proposed acreage attribution unit for oil wells.

API No. 15 - 125-31487-0000
Operator: Jordan Wilson
Lease: Clarkson 41
Well Number: 7
Field: Jefferson-Sycamore

Number of Acres attributable to well: _____
QTR/QTR/QTR/QTR of acreage: ~~SW~~ - ~~NW~~ - NW - ~~SW~~
NE SW NW

Location of Well: County: Montgomery

~~800~~ 900 feet from ☒ N / ☐ S Line of Section

400 feet from ☐ E / ☒ W Line of Section

Sec. 27 Twp. 33 S. R. 15 ☒ E ☐ W


Is Section: ☒ Regular or ☐ Irregular

If Section is Irregular, locate well from nearest corner boundary.

Section corner used: ☐ NE ☐ NW ☐ SE ☐ SW**PLAT**


(Show location of the well and shade attributable acreage for prorated or spaced wells.)

(Show footage to the nearest lease or unit boundary line.)

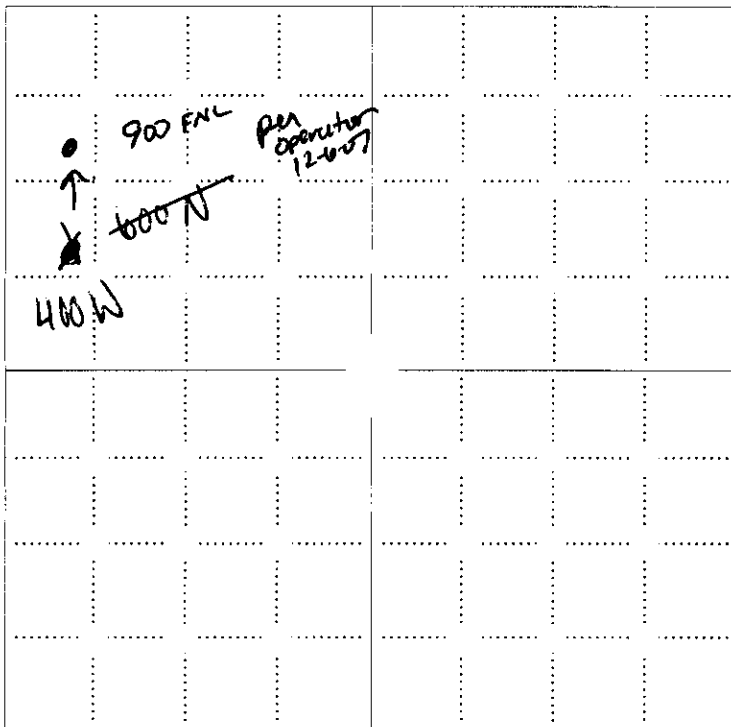

NOTE: In all cases locate the spot of the proposed drilling locaton.

RECEIVED
KANSAS CORPORATION COMMISSION
DEC 06 2007
CONSERVATION DIVISION
WICHITA, KS

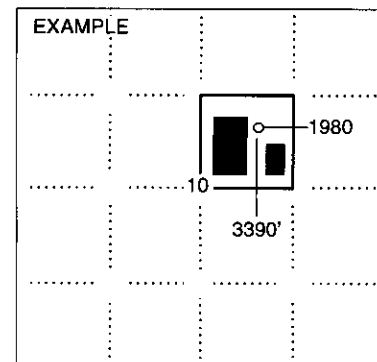

SEWARD CO.

In plotting the proposed location of the well, you must show:

1. The manner in which you are using the depicted plat by identifying section lines, i.e. 1 section, 1 section with 8 surrounding sections, 4 sections, etc.
2. The distance of the proposed drilling location from the south / north and east / west outside section lines.
3. The distance to the nearest lease or unit boundary line (in footage).
4. If proposed location is located within a prorated or spaced field a certificate of acreage attribution plat must be attached: (C0-7 for oil wells; CG-8 for gas wells).

**KANSAS CORPORATION COMMISSION
OIL & GAS CONSERVATION DIVISION
APPLICATION FOR SURFACE PIT**

RECEIVED
KANSAS CORPORATION COMMISSION
DEC 06 2007
CONSERVATION DIVISION

Form CDP-1
April 2004
Form must be Typed

Submit in Duplicate

Operator Name: Jordan Wilson		License Number: 33181	
Operator Address: 5994 Palm RD.		Neosho MO. 64850	
Contact Person: Jordan Wilson		Phone Number: 417-455-3578	
Lease Name & Well No.: Clarkson 41 7		Pit Location (QQQQ): NE NW - SW - NW - NW Sec. <u>27</u> Twp. <u>33</u> R. <u>15</u> ☒ East ☐ West <u>600</u> Feet from ☒ North / ☐ South Line of Section <u>400</u> Feet from ☐ East / ☒ West Line of Section Montgomery County	
Type of Pit: ☐ Emergency Pit ☐ Burn Pit ☐ Settling Pit ☒ Drilling Pit ☐ Workover Pit ☐ Haul-Off Pit (If WP Supply API No. or Year Drilled)		Pit is: ☒ Proposed ☐ Existing If Existing, date constructed: _____ Pit capacity: 5,000 (bbls)	
Is the pit located in a Sensitive Ground Water Area? ☐ Yes ☒ No		Chloride concentration: _____ mg/l (For Emergency Pits and Settling Pits only)	
Is the bottom below ground level? ☐ Yes ☒ No		Artificial Liner? ☐ Yes ☒ No	
How is the pit lined if a plastic liner is not used? above ground level			
Pit dimensions (all but working pits): <u>12</u> Length (feet) <u>12</u> Width (feet) ☐ N/A: Steel Pits Depth from ground level to deepest point: <u>15</u> (feet) ☐ No Pit			
If the pit is lined give a brief description of the liner material, thickness and installation procedure. N/A		Describe procedures for periodic maintenance and determining liner integrity, including any special monitoring. N/A	
Distance to nearest water well within one-mile of pit <u>N/A 728</u> feet Depth of water well <u>52</u> feet		Depth to shallowest fresh water <u>150 27</u> feet. Source of information: ☐ measured ☒ well owner ☐ electric log ☒ KDWR	
Emergency, Settling and Burn Pits ONLY: Producing Formation: _____ Number of producing wells on lease: _____ Barrels of fluid produced daily: _____ Does the slope from the tank battery allow all spilled fluids to flow into the pit? ☐ Yes ☐ No		Drilling, Workover and Haul-Off Pits ONLY: Type of material utilized in drilling/workover: <u>WATER</u> Number of working pits to be utilized: <u>1</u> Abandonment procedure: <u>FILL IN BY DOZER</u> Drill pits must be closed within 365 days of spud date.	
I hereby certify that the above statements are true and correct to the best of my knowledge and belief. <u>11-1-07</u> Date Signature of Applicant or Agent			

15-125-31487-0000

KCC OFFICE USE ONLY		Steel Pit ☐	RFAC ☐	RFAS ☐
Date Received: <u>12/6/07</u>	Permit Number: _____	Permit Date: <u>12/6/07</u>	Lease Inspection: ☐ Yes ☒ No	

Mail to: KCC - Conservation Division, 130 S. Market - Room 2078, Wichita, Kansas 67202