

Dist. 1

* 12-28-07
CORRECTED

Correction

CARD MUST BE TYPED

State of Kansas

CARD MUST BE SIGNED

EFFECTIVE DATE 2-8-06

NOTICE OF INTENTION TO DRILL
HUGOTON INFILL

SGA - YES

Starting Date . . . March 27, 2006
month day year

API Number 15 - 175-22031-00-00

OPERATOR: License # 8061 ✓
Name Oil Producers Inc. of Kansas ✓
Address 1710 Waterfront Parkway
City/State/Zip Wichita, KS 67206
Contact Person Lori Wedel
Phone 316-681-0231

CONTRACTOR: License # 33375 ✓
Name Cheyenne Drilling LP
City/State Garden City, KS
Well Drilled as: New Recompletion OWWO
Projected Total Depth 2800' feet
Formation Chase Group Formation
If OWWO or Recompletion: old well info as follows:
Operator
Well Name
Comp. Date Old Total Depth

IS SECTION REGULAR IRREGULAR
C. SW. Sec. 33 Twp. 32 S, Rg. 32 W
Ft. from South Line of Section
1320' 1440'
Ft. from East Line of Section
3960' 3830'
NOTE: Attach acreage attribution plat locating both Chase (Hugoton) wells
Total number of acres attributed to unit . . . 640
Nearest producing well from
same common source of supply . . . 3342' feet
Nearest lease or unit boundary line. . . . 1320' feet ✓
County Seward
Lease Name . . Wettstein Well # . . 2A-33
Ground surface elevation Est. 2818 feet MSL
Depth to bottom of fresh water 620
Depth to bottom of usable water 640
Surface pipe by Alternate: 1 X 2
Surface pipe planned to be set . . . 1660
Water Source for Drilled Operations:
DWR Permit #: well farm pond other

I certify that well will comply with K.S.A. 55-101, et seq., plus eventually plugging hole to KCC specifications.
Date 1-31-06 Signature of Operator or Agent [Signature] Title PRESIDENT

For KCC Use:
Conductor Pipe Required NONE feet; Minimum Surface Pipe Required 660 feet per Alt 13
This Authorization Expires 8-2-06 Approved By RJR 2-3-06 9/95
Kans 12-28-07

12-28-07
* WAS: 1320' FSL, 3960' FEL
IS: 1440' FSL, 3830' FEL


RECEIVED
KANSAS CORPORATION COMMISSION

Must be filed with K.C.C. five (5) days prior to commencing well
This card void if drilling not started within six (6) months of date received by K.C.C.

FEB 01 2006

CONSERVATION DIVISION
WICHITA, KS

A Regular Section of Land
1 Mile = 5,280 Ft.

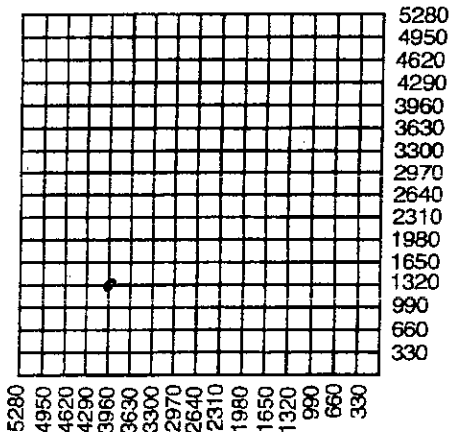

Important procedures to follow:

1. Notify District office before setting surface casing.
2. Set surface casing by circulating cement to the top.
3. File completion forms ACO-1 with K.C.C. within 120 days of well spud date, following instructions on ACO-1, side 1, and including copies of wireline logs.
4. Notify District office 48 hours prior to old well workover or re-entry.
5. Submit plugging report (CP-4) to K.C.C. after plugging is completed.
6. If an alternate 2 completion, cement in the production pipe from below any useable water to surface within 120 days of spud date.

RECEIVED
KANSAS CORPORATION COMMISSION

DEC 21 2007

CONSERVATION DIVISION
WICHITA, KS

State Corporation Commission of Kansas
Conservation Division
130 S. Market Room 2078
Wichita, Kansas 67202-1212
(316) 337-6231