


STATE OF KANSAS  
STATE CORPORATION COMMISSION

Give All Information Completely  
Make Required Affidavit  
Mail or Deliver Report to:  
Conservation Division  
State Corporation Commission  
211 No. Broadway  
Wichita, Kansas

15-143-00008-00-00

WELL PLUGGING RECORD

NORTH

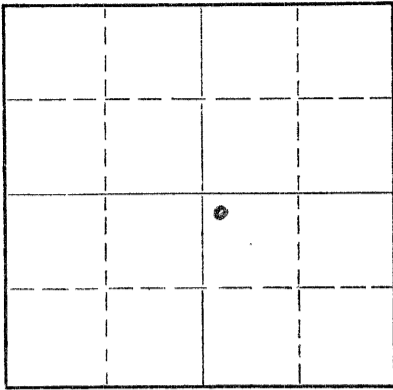

Locate well correctly on above  
Section Plat

Ottawa County. Sec. 21 Twp. 9 Rge. - (E) 5 (W)  
Location as "NE/CNW/SW" or footage from lines NW NW SE  
Lease Owner E. K. Carey Drilling Co., Inc.  
Lease Name Srna Well No. 1  
Office Address Box 620, McPherson, Kansas  
Character of Well (completed as Oil, Gas or Dry Hole) Dry  
Date well completed January 23, 1960  
Application for plugging filed January 23, 1960  
Application for plugging approved January 23, 1960  
Plugging commenced 10:00 AM January 23, 1960  
Plugging completed January 23, 1960  
Reason for abandonment of well or producing formation Non Productive

If a producing well is abandoned, date of last production 19  
Was permission obtained from the Conservation Division or its agents before plugging was commenced? Yes

Name of Conservation Agent who supervised plugging of this well Gilbert J. Toman, Holyrood, Kansas  
Producing formation \_\_\_\_\_ Depth to top \_\_\_\_\_ Bottom \_\_\_\_\_ Total Depth of Well 3295 Feet  
Show depth and thickness of all water, oil and gas formations.

OIL, GAS OR WATER RECORDS

CASING RECORD

FORMATION	CONTENT	FROM	TO	SIZE	PUT IN	PULLED OUT
				8-5/8"	277'	None

Describe in detail the manner in which the well was plugged, indicating where the mud fluid was placed and the method or methods used in introducing it into the hole. If cement or other plugs were used, state the character of same and depth placed, from \_\_\_\_\_ feet to \_\_\_\_\_ feet for each plug set.

Filled with mud to 270', put in 1/4 sack hulls, mixed 20 sacks cement and put thru drill pipe. Mud to 40', put 1/4 sack hulls and 10 sacks cement and filled to bottom of cellar floor. Pulled rat hole and put in 2 sacks cement.

2-19-60

(If additional description is necessary, use BACK of this sheet)  
Name of Plugging Contractor Rosencrantz-Bemis Equipment Co., Inc.  
Address Great Bend, Kansas

STATE OF Kansas, COUNTY OF McPherson, ss.  
Arland Bruce, Superintendent (employee of owner) or (owner or operator) of the above-described well, being first duly sworn on oath, says: That I have knowledge of the facts, statements, and matters herein contained and the log of the above-described well as filed and that the same are true and correct. So help me God.

(Signature) Arland Bruce Supt.  
Box 620, McPherson, Kansas  
(Address)

SUBSCRIBED AND SWORN TO before me this 18th day of February, 1960

My commission expires November 13, 1960 [Signature] Notary Public.



WELL LOG

Company: E. K. Carey Drilling Co., Inc.  
Farm: Syria #1

Sec. 21-95-5N  
County: Ottawa, Kansas

Total Depth: 3295'  
Commence: 1-6-60 Completion: 1-23-60  
Contractor: Rosenkrantz-Bemis Equipment Co., Inc.

Post Rock	35'
Sand	70'
Shale	185'
Sand and Shale	230'
Shale	525'
Lime and Shale	710'
Shale	810'
Shale with lime streaks	840'
Lime and Shale	1160'
Shale and Lime	2628'
Lime	3072'
Lime and Shale	3175'
Hard Shale and Lime	3225'
Shale and Lime	3245'
Chert	3250'
Mississippi	3295'

STATE COMMISSION  
FEB 19 1960

2-19-60

Plugged hole with 1 1/2 sacks of hulls, 20 sacks of cement @ 270', Top plug @ 40' with 1/2 sacks of hulls and 10 sacks of cement

We hereby certify this to be a correct and accurate log of the above described well as shown on the daily drilling report.

ROSENKRANTZ-BEMIS EQUIPMENT CO., INC.

By: *C. J. Nettleton*

Subscribed and sworn to before me this 12th day of February, 1960.

*Sweeney D. Miller*  
Notary Public

My Commission Expires: 24 October 1960