


15-143-00003-00-00

Give All Information Completely
Make Required Affidavit
Mail or Deliver Report to:
Conservation Division
State Corporation Commission
800 Bittig Building
Wichita, Kansas

WELL PLUGGING RECORD

NORTH

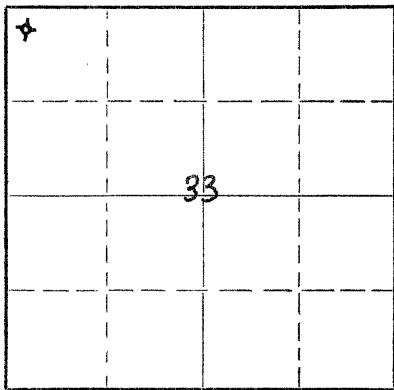

Locate well correctly on above
Section Plat

Ottawa County. Sec. 33 Twp. 9S Rge. 5 (K) (W)

Location as "NE/CNW/SW" or footage from lines C NW/4 NW/4 NW/4

Lease Owner Morris Veverka, J. N. Gassoway, V. R. Ordway

Lease Name Kiem Well No. 1

Office Address Plainville, Kansas

Character of Well (completed as Oil, Gas or Dry Hole) Dry Hole

Date well completed June 23, 19 52

Application for plugging filed 19

Application for plugging approved 19

Plugging commenced June 23, 19 52

Plugging completed June 23, 19 52

Reason for abandonment of well or producing formation Dry Hole

If a producing well is abandoned, date of last production 19

Was permission obtained from the Conservation Division or its agents before plugging was commenced? Yes (Verbally)

Name of Conservation Agent who supervised plugging of this well Rael Durkee

Producing formation _____ Depth to top _____ Bottom _____ Total Depth of Well 3805 Feet

Show depth and thickness of all water, oil and gas formations.

OIL, GAS OR WATER RECORDS

CASING RECORD

FORMATION	CONTENT	FROM	TO	SIZE	PUT IN	PULLED OUT
				10-3/4"	175'	None

Describe in detail the manner in which the well was plugged, indicating where the mud fluid was placed and the method or methods used in introducing it into the hole. If cement or other plugs were used, state the character of same and depth placed, from _____ feet to _____ feet for each plug set.

From 3805' to 175' - Heavy mud
 " 175' " 115' - Wood plug set at 175', filled with 20 sacks of cement
 " 115' " 20' - Heavy mud
 " 20' " 6' - Wood plug set at 20', filled with 5 sacks of cement
 " 6' " 0' - Surface soil

(If additional description is necessary, use BACK of this sheet)

Name of Plugging Contractor J. A. Melland, Drilling Contractor

Address 1111 North Main, Hutchinson, Kansas

STATE OF Kansas, COUNTY OF Rooks, ss.
Morris Veverka (employee of owner) or (owner or operator) of the above-described

well, being first duly sworn on oath, says: That I have knowledge of the facts, statements, and matters herein contained and the log of the above-described well as filed and that the same are true and correct. So help me God.

(Signature) Morris Veverka

(Address) Plainville, Kas.

SUBSCRIBED AND SWORN TO before me this 7th day of July 1952

Amelia Hawk
Notary Public.

My commission expires 11-10-1955

33.9 SW
25.4V

7-8-52

WELL RECORD

1543-0003-0000

LEASE NAME Klem WELL NO. 1 ELEV. _____

LOCATION NW/4 NW/4 NW/4 Sec. 33-9S-5W, Ottawa County, Kansas

WORK COMMENCED June 3, 1952 DRILLING COMMENCED June 5, 1952

DRILLING COMPLETED June 22, 1952

DRILLING CONTRACTOR J. A. Melland, 1111 North Main, Hutchinson, Kansas

ROTARY DRILLING FROM 0' TO 3805'

FORMATION	FROM	TO	REMARKS
Lime and blue shale	0	55	
Shale and sand	55	195	
Red bed shale	195	395	
Shale and shells	395	485	
Lime and anhydrite	485	520	Reamed 9" hole to 13-3/4" hole to 175'. Set and cemented 10-3/4" OD casing at 175' w/ 150 sacks of cement and 200# of calcium chloride
Lime	520	550	
Shale and red bed	550	570	
Shale and shells	570	740	
Blue shale	740	820	
Lime	820	851	
Shale and lime	851	970	
Shale and broken lime	970	1115	
Lime and shale	1115	1225	
Lime	1225	1265	
Shale	1265	1305	
Lime and shale	1305	1365	
Shale and lime	1365	1755	
Lime and shale	1755	1995	
Blue shale, grey shale, lime and shells	1995	2180	
Shale and lime	2180	2270	
Lime and shale	2270	2360	
Shale and lime	2360	2440	Circulated for samples @ 2405' 1 hr
Lime and shale	2440	2645	Circulated for samples @ 2560' 1 hr
Lime	2645	2770	Circulated for samples @ 2690' 1 hr
Lime and shale	2770	2865	
Shale and lime	2865	2982	Circulated for samples @ 2982' 1/2 hr
Lime and shale	2982	3055	Circulated for samples @ 2982' 1/2 hr
Shale and lime	3055	3180	
Lime and shale	3180	3270	Circulated for samples @ 3229' 1 hr
Lime	3270	3319	Circulated for samples @ 3290' 1 hr
			Circulated for samples @ 3312' 1 hr
Lime and chert	3319	3340	
Chert and lime	3340	3365	
Lime and chert	3365	3440	
Lime and shale	3440	3500	
Lime	3500	3558	
Lime and shale	3558	3575	
Shale and lime	3575	3610	
Lime, shale and chert	3610	3629	Top Viola Lime 3612'
Cherty lime	3629	3648	
Lime and chert	3648	3660	
Cherty lime	3660	3675	
Lime and chert	3675	3740	
Lime and shale	3740	3775	Circulated for samples @ 3753' 1 hr
			Circulated for samples @ 3759' 1 hr
Lime	3775	3805	Circulated 1 hr. @ 3805'
TOTAL DEPTH		3805	

RECEIVED
 CORPORATION COMMISSION
 OCT 29 1952
 CONSERVATION DIVISION
 Wichita, Kansas

10-9-52

As no oil or gas was encountered in commercial quantities, authority was granted to plug the well under directions of Ruel Durkee, S.C.C. well plugger, as follows: Heavy mud from 3805' to 175', plug set at 175', 20 sacks of cement from 175' to 115', mud from 115' to 20', plug set at 20', 5 sacks of cement from 20' to 6', surface soil from 6' to 0', plugged and abandoned 6/23/52. Slope tests taken at regular intervals showed no deflections from the vertical.