


15-123-00006-00-00

STATE OF KANSAS  
STATE CORPORATION COMMISSION

Give All Information Completely  
Make Required Affidavit  
Mail or Deliver Report to:  
Conservation Division  
State Corporation Commission  
800 Bitting Building  
Wichita, Kansas

WELL PLUGGING RECORD

NORTH

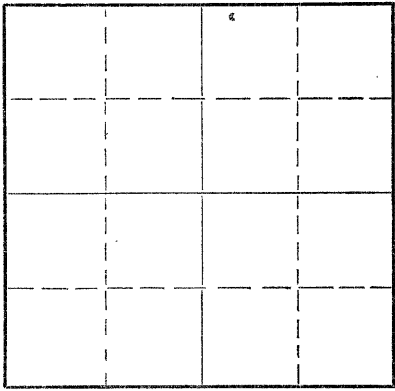

Locate well correctly on above  
Section Plat

Mitchell County. Sec. 11 Twp. 9S Rge. 7 (E) W (W)  
Location as "NE/CNW/SW" or footage from lines SW SW SW  
Lease Owner Harms and Knight Drlg. Co., Prod. Dept.  
Lease Name Peters Well No. 1  
Office Address Great Bend, Kansas  
Character of Well (completed as Oil, Gas or Dry Hole) Dry Hole  
Date well completed 8-25 19 52  
Application for plugging filed " 19  
Application for plugging approved " 19  
Plugging commenced " 19  
Plugging completed " 19  
Reason for abandonment of well or producing formation

If a producing well is abandoned, date of last production 19  
Was permission obtained from the Conservation Division or its agents before plugging was commenced? Yes

Name of Conservation Agent who supervised plugging of this well Ruell Durkee  
Producing formation Depth to top Bottom Total Depth of Well 3985 Feet  
Show depth and thickness of all water, oil and gas formations.

OIL, GAS OR WATER RECORDS

CASING RECORD

FORMATION	CONTENT	FROM	TO	SIZE	PUT IN	PULLED OUT
		0	158	8 5/8"	8-9-52	

Describe in detail the manner in which the well was plugged, indicating where the mud fluid was placed and the method or methods used in introducing it into the hole. If cement or other plugs were used, state the character of same and depth placed, from feet to feet for each plug set.

Gun pits and circulated 30 minutes on bottom.  
Lay down 1/2 drill pipe. Gun pits and circulate  
30 minutes. Filled hole with heavy mud. Set bottom  
plug @ 158' cemented with 15 sacks cement.  
Set top plug @ 10 ft. Cemented with 5 sacks cement.

(If additional description is necessary, use BACK of this sheet)  
Name of Plugging Contractor Harms and Knight Drilling Company 10-17-52  
Address Great Bend, Kansas


STATE OF Kansas COUNTY OF Barton, ss.  
Allan Harms (employee of owner) or (owner or operator) of the above-described well, being first duly sworn on oath, says: That I have knowledge of the facts, statements, and matters herein contained and the log of the above-described well as filed and that the same are true and correct. So help me God.

(Signature) Allan Harms  
Great Bend, Kansas (Address)

SUBSCRIBED AND SWORN TO before me this 6th day of October, 1952

My commission expires Sept. 15, 1956  
Walter J. Volk Notary Public.

24-2675-S 2-52-20M

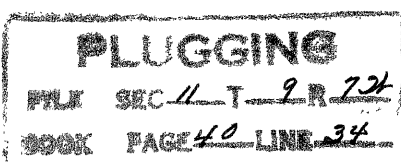

Harms and Knight Drilling Co., Prod. Dept.  
Great Bend, Kansas

Lease: Peters  
well No: 1

SW-SW-SW  
Sec. 11-9S-7W  
Mitchell County, Kansas

Total Depth: 3985  
Comm: 8-8-52 Comp: 8-26-52  
Contractor: Harms and Knight Drlg. Co.  
Rotary: 0-3985

Elevation: 1487 DF - 1489 RB  
Production: Dry & Abandoned

Casing Record: 8 5/8" set @ 158' cemented with 144 sacks cement, circulated.

Figures indicate bottoms of formations:

Tops:

Soil & Rock	60	Heebner	2441
Sand	65	Lansing	2631
Shale & Shells	158	Mississippian	3233
Shale	170	Rinderhook	3424
Shale & Shells	440	Hunton	3482
Sand	580	Maquoketa	3581
Shells & Pyrite	600	Viola	3639
Shale & Sand	650	Simpson	3874
Shale & Shells	850	Arbuckle	3932
Shale & Lime	1056		
Shale & Shells	1230		
Lime	1262		
Shale & Shells	1320		
Shale & Lime	1450		
Shale & Shells	2300		
Shale & Lime	2415		
Shale & Shells	2534		
Shale & Lime	2600		
Lime	2665		
Lime & Shale	2763		
Lime	2950		
Lime & shale	3038		
Shale	3101		
Shale & Shells	3215		
Shale	3226		
Sand	3234		
Chert & Lime	3287		
Chert, Lime & Shale	3345		
Lime & Chert	3364		
Shale	3379		
Lime	3435		
Shale & Chert	3525		
Shale	3555		
Lime & Shale	3605		
Shale	3702		
Lime	3731		
Lime & Shale	3808		
Lime	3860		
Lime & Shale	3918		
Shale & Sand	3933		
Lime	3985		
Total Depth	3985'		

We hereby certify this to be a correct and accurate log of the above described well as shown on the daily drilling reports.

HARMS AND KNIGHT DRILLING COMPANY  
Production Dept.

BY Alfred Harms

Subscribed and sworn to before me this 6<sup>th</sup> day of October 1952

Walter J. Volk  
Notary Public

My commission expires:

Sept. 15, 1956

