


Give All Information Completely
Make Required Affidavit
Mail or Deliver Report to:
Conservation Division
State Corporation Commission
211 No. Broadway
Wichita, Kansas

Osborne County, Sec. 28 Twp. 9 Rge. 15W (E) (W)

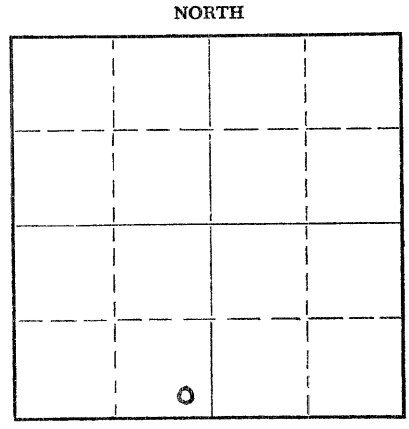

Location as "NE/CNW/SW" or footage from lines SE SE SW
Lease Owner Vanguard Drilling, Inc.
Lease Name Hogan Well No. 1
Office Address 223 Beacon Bldg. Wichita, Kansas
Character of Well (completed as Oil, Gas or Dry Hole) dry hole
Date well completed 1-10-59 19
Application for plugging filed 1-9-59 19
Application for plugging approved 1-9-59 19
Plugging commenced 1-9-59 19
Plugging completed 1-10-59 19
Reason for abandonment of well or producing formation dry

Locate well correctly on above
Section Plat

If a producing well is abandoned, date of last production _____ 19
Was permission obtained from the Conservation Division or its agents before plugging was commenced? yes

Name of Conservation Agent who supervised plugging of this well John Trueman
Producing formation none Depth to top _____ Bottom _____ Total Depth of Well 3890 Feet
Show depth and thickness of all water, oil and gas formations.

OIL, GAS OR WATER RECORDS

CASING RECORD

FORMATION	CONTENT	FROM	TO	SIZE	PUT IN	PULLED OUT

Describe in detail the manner in which the well was plugged, indicating where the mud fluid was placed and the method or methods used in introducing it into the hole. If cement or other plugs were used, state the character of same and depth placed, from _____ feet to _____ feet for each plug set.

Set bottom plug at 170 ft., bridge and 1/4 sack of hulls on top of bridge, then 25 sacks of mixed cement through drill pipe. Set top plug at 40ft., then 1/4 sack of hulls and 10 sacks of cement. Job completed at 3:45 a.m. 1-10-59.

RECEIVED
STATE CORPORATION COMMISSION
JAN 14 1959
01-14-1959
CONSERVATION DIVISION
Wichita, Kansas

(If additional description is necessary, use BACK of this sheet)
Name of Plugging Contractor none
Address _____

STATE OF Kansas, COUNTY OF Sedgwick, ss.
H. J. Groves (employee of owner) or (owner or operator) of the above-described well, being first duly sworn on oath, says: That I have knowledge of the facts, statements, and matters herein contained and the log of the above-described well as filed and that the same are true and correct. So help me God.

(Signature) H. J. Groves
223 Beacon Bldg. Wichita, Kansas
(Address)

SUBSCRIBED AND SWORN TO before me this 12th day of January, 1959

My commission expires 1-24-59
Notary Public.

PLUGGING
FILE SEC 28 T 9 R 15W
BOOK PAGE 10 LINE 40

KANSAS GEOLOGICAL SOCIETY
KANSAS WELL LOG BUREAU - KANSAS WELL SAMPLE BUREAU
 KANSAS GEOLOGICAL SOCIETY BUILDING
 508 EAST MURDOCK - WICHITA, KANSAS

COMPANY

15-141-00051-00-00

Drill. Inc.

SEC. 28 T. 9 R.

LOC. 36 26 24

FARM

Open

NO.

1

TOTAL DEPTH

3862

COMM.

2-30-58

COMP. 1-18-59


COUNTY Osage

KANSAS

SHOT OR TREATED

CONTRACTOR

ISSUED

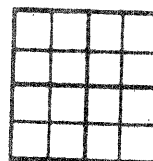

CASING

20	10	
15	8	173'
12	6	
13	5	

ELEVATION 3000 FT

PRODUCTION D 4 1/2

FIGURES INDICATE BOTTOM OF FORMATIONS

2962	Shale
3196	lss
3214	shale
3251	lss
3514	shale
3514	lss
3657	shale
3657	lss & shale
3697	Shale & chert
3797	Chert & lss
3797	Shale
3851	Lss
3862	Shale & lss
3862	Lss
	Total depth

Top	2962
Heab	3196
Top	3214
Base	3251
4/Kc	3514
Base	3657
Top	3697
Stamp	3797
And	3862

RECEIVED
 STATE CORPORATION COMMISSION

JAN 14 1959

CONSERVATION DIVISION
 Topeka, Kansas

PLUGGING
 FILE SEC 28 T. 9 R. 15W
 BOOK PAGE 10 LINE 40