


STATE OF KANSAS
STATE CORPORATION COMMISSION

Give All Information Completely
Make Required Affidavit
Mail or Deliver Report to:
Conservation Division
State Corporation Commission
800 Biting Building
Wichita, Kansas

15-163-00965-00-00
WELL PLUGGING RECORD

NORTH

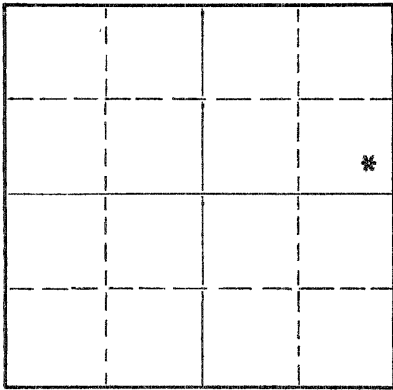

Locate well correctly on above
Section Plat

Rooks _____ County. Sec. 18 Twp. 9 Rge. 16 (E) W (W)
Location as "NE/CNW/SW" or footage from lines SE SE NE/4
Lease Owner Altman Petroleum Co.
Lease Name ~~Golehan~~ Colahan KCC Well No. 1
Office Address 118 N. Boulder Tulsa, Oklahoma
Character of Well (completed as Oil, Gas or Dry Hole) dry hole
Date well completed June 24 19 56
Application for plugging filed June 24 19 56
Application for plugging approved June 24 19 56
Plugging commenced June 24 19 56
Plugging completed June 24 19 56
Reason for abandonment of well or producing formation dry hole

If a producing well is abandoned, date of last production _____ 19 ____
Was permission obtained from the Conservation Division or its agents before plugging was commenced? yes

Name of Conservation Agent who supervised plugging of this well Eldon Petty
Producing formation _____ Depth to top _____ Bottom _____ Total Depth of Well 3431 Feet
Show depth and thickness of all water, oil and gas formations.

OIL, GAS OR WATER RECORDS

CASING RECORD

FORMATION	CONTENT	FROM	TO	SIZE	PUT IN	PULLED OUT
Surface pipe		-0-	194	8 5/8	194	-0-

Describe in detail the manner in which the well was plugged, indicating where the mud fluid was placed and the method or methods used in introducing it into the hole. If cement or other plugs were used, state the character of same and depth placed, from _____ feet to _____ feet for each plug set.

Filled with rotary mud to 180'
Set wood plug
Dumped 1/3 sack hulls 15 sacks cement
Filled with rotary mud to 40'
Set wood plug
Dumped 1/3 sack hulls, 10 sacks cement.

(If additional description is necessary, use BACK of this sheet)

Name of Plugging Contractor A. L. Jackson Drilling Co.
Address Box 194 Great Bend, Kansas

STATE OF Kansas, COUNTY OF Barton, ss.
A. L. Jackson, contractor on (employee of owner) or (owner or operator) of the above-described well, being first duly sworn on oath, says: That I have knowledge of the facts, statements, and matters herein contained and the log of the above-described well as filed and that the same are true and correct. So help me God.

(Signature) A. L. Jackson
Box 194 Great Bend, Kansas
(Address)

SUBSCRIBED AND SWORN TO before me this 25th day of June, 19 56

Nice J. Carus
Notary Public.

My commission expires May 9, 1959

PLUGGING
FILE SEC 18 T 9 R 16W
BOOK PAGE 75 LINE 10

15-163-00965-08-00

KCC
2AP
Well Log
Colahan ~~Colahan~~ # 1
SE SE NE 18-28-16W

Rooks County, Kansas

0-155	Sand and shale
155-194	Blue shale
194-575	Shale and sand
575-810	Shale, shells and sand
810-890	Sand
890-1150	Red bed, shale and shells
1150-1215	Shale and shells
1215-1245	Anhydrite
1245-1385	Shale
1385-1635	Shale, shells and salt
1635-1690	Shale and shells
1690-1760	Shale and lime streaks
1760-1920	Shale and lime
1920-2740	Lime and shale
2740-2790	Shale
2790-3000	Lime and shale
3000-3125	Lime
3125-3155	Lime and shale
3155-3225	Lime, Kansas City
3225-3310	Lime
3310-3415	Lime and shale
3415-3/31	Lime
3431	TD

State of Kansas

County of Barton ss

A. L. Jackson, owner of A. L. Jackson Drilling Company, being first duly sworn on oath says: That I have knowledge of the facts, statements, and matters herein contained and the log of the above described well as filed and that the same are true and correct.

A. L. Jackson
A. L. Jackson

Subscribed and sworn before me this 25th day of June, 1956

Dick B. Evans
Dick B. Evans
Notary Public Barton County

My Commission expires May 9, 1959

7/2/56

PLUGGING			
FILE	SEC. 18	T. 9	R. 16W
BOOK	PAGE 75	LINE 10	