

15-163-02787-00-00

STATE OF KANSAS
STATE CORPORATION COMMISSION


WELL PLUGGING RECORD

OR
FORMATION PLUGGING RECORD

Strike out upper line
when reporting plugging
off formations.

Give All Information Completely
Make Required Affidavit
Mail or Deliver Report to:
Conservation Division
State Corporation Commission
800 Bittig Building
Wichita, Kansas

Rooks County. Sec. 18 Twp. 9 Rge. 16 (E) 16 (W)
Location as "NE 1/4 NW 1/4 SW 1/4" or footage from lines 330 N 330 W of S.E. Corner
Lease Owner: Cities Service Oil Company
Lease Name: Bell Well No. 1
Office Address: Bartlesville, Oklahoma
Character of Well (completed as Oil, Gas or Dry Hole): Dry Hole
Date well completed: 10-23 19. 47
Application for plugging filed: 11-1 19. 47
Application for plugging approved: 11-1 19. 47
Plugging commenced: 11-13 19. 47
Plugging completed: 11-22 19. 47
Reason for abandonment of well or producing formation:

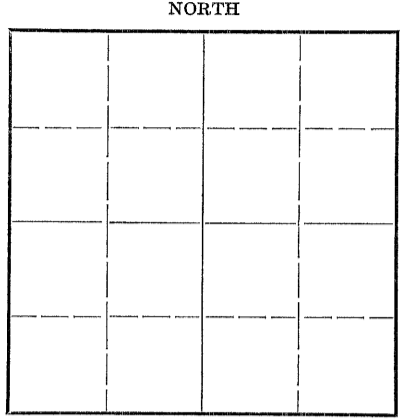

Locate well correctly on above
Section Plat

If a producing well is abandoned, date of last production: 19.
Was permission obtained from the Conservation Division or its agents before plugging was commenced? Yes

Name of Conservation Agent who supervised plugging of this well: Mr. G. D. Stough
Producing formation: Arbuckle Lime Depth to top: 3437 Bottom: Total Depth of Well: 3473 Feet
Show depth and thickness of all water, oil and gas formations.

OIL, GAS OR WATER RECORDS

CASING RECORD

Formation	Content	From	To	Size	Put In	Pulled Out
Arbuckle Lime	Water			8 5/8	235'	0
				5 1/2	3473'	2614'

Describe in detail the manner in which the well was plugged, indicating where the mud fluid was placed and the method or methods used in introducing it into the hold. If cement or other plugs were used, state the character of same and depth placed, from _____ feet to _____ feet for each plug set.

Filled with sand and mud from total depth to 3117', set plug dumped 5 sacks cement mud to 236'. Set plug dumped 15 sacks cement, mud to 30' dumped 10 sacks cement mud and dirt to surface.

12/16/47

(If additional description is necessary, use BACK of this sheet)


Correspondence regarding this well should be addressed to: Mr. R. C. Cooper
Address: Cities Service Oil Co.
Bartlesville, Oklahoma

STATE OF Kansas, COUNTY OF Barton, ss.
Mr. James Porter (employee of owner) or (owner or operator) of the above-described well, being first duly sworn on oath, says: That I have knowledge of the facts, statements, and matters herein contained and the log of the above-described well as filed and that the same are true and correct. So help me God.

(Signature) James Porter
Box 553 Russell, Kansas (Address)

SUBSCRIBED AND SWORN to before me this 5th day of December 1947
W. G. Smith
Notary Public.

My commission expires 3-12-1951

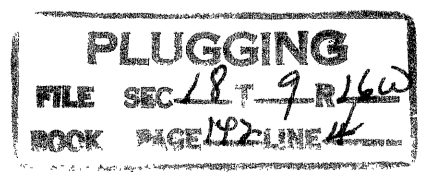

15-163-02787-00-00

WELL RECORD

Company Cities Service Oil Co. Well No. 1 Farm Bell
 Location 330' North and 330' West of SW Corner Sec. 18 T. 9 R. 16-W
 Elevation 1986 (1984 Cr.) County Rooks State Kansas
 Drlg. Comm. September 21, 1947 Contractor H. W. Kins Drilling Company
 Drlg. Comp. October 2, 1947 Acid 6,500 gals. See below.
 T. D. 3473' Initial Prod None - Dry Hole

CASING RECORD:

8-5/8" @ 235' con. 125 sq con. and
 100' C. C.
 5-1/2" @ 3473' con. 150 sq con.

FORMATION RECORD:

surface rock & shale	0-100
shale & rock	235
shale & gravel	385
shale & sand	1245
sandy shale	1430
anhydrite	1460
shale & shells	1585
shale	1785
shale & shells	1980
lime & shale	2450
shale & lime	2800
shale & shells	3105
lime	3110
shale & shells	3125
lime	3433
lime & shale	3470

3470 Rot. TD = 3473 SLM

Corr. Top Lansing	3115'
Corr. Top Eros. Arbuckle	3433'
Corr. Top Arbuckle	3437'
Penetration	36'
Total Depth	3473'

Drilled cement to 3455 SLM.

Perf. 7 shots 3432-35
 875' water in 15 mins.
 1875' water in 1 hour
 2643' water in 2-1/4 hours

Set Lane-Wells plug at 3390 SLM.

Perf. 36 shots	3350-61 1/2
35 shots	3326-37
52 shots	3300-17
36 shots	3282-93
83 shots	3220-43
24 shots	3176-82
30 shots	3156-64
18 shots	3120-26

2 gals. oil, 15 gals. water, per hour.


Acidized 3000 gals. 3282-3361 1/2. Pumped
 1/2 bbl. oil, 17 bbls. water, 24 hrs.

Acidized 1500 gals. 3220-43
 Acidized 2000 gals. 3120-82

Pumped 3 oil, 37 water, 14 hours.

500'	00
1000'	10
1500'	00
2000'	00
2500'	10

7-7/8" rotary hole.

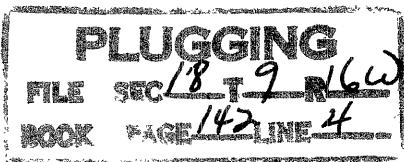

12/16/47