


STATE OF KANSAS
STATE CORPORATION COMMISSION
Give All Information Completely
Make Required Affidavit
Mail or Deliver Report to:
Conservation Division
State Corporation Commission
800 Bitting Building
Wichita, Kansas

OR
FORMATION PLUGGING RECORD

Strike out upper line
when reporting plug-
ging off formations.

Rooks County. Sec. 18 Twp. 9 Rge. 16 (W)
Location as "NE 1/4 NW 1/4 SW 1/4" or footage from lines. C W/2 NW NW
Lease Owner Donald T. Ingling, et al
Lease Name Colahan Well No. 2
Office Address 708 Fourth Nat'l Bank Bldg., Wichita 2, Kansas
Character of Well (completed as Oil, Gas or Dry Hole) Dry Hole
Date well completed 1/16 19 46
Application for plugging filed 1/16 19 46
Application for plugging approved 1/16 19 46
Plugging commenced 1/16 19 46
Plugging completed 1/16 19 46
Reason for abandonment of well or producing formation

NORTH

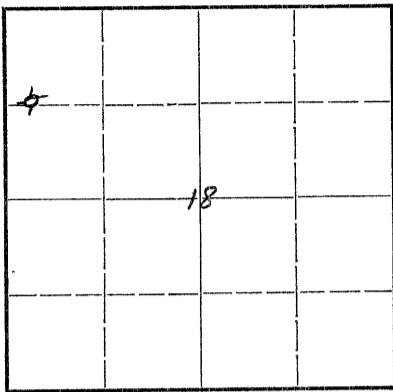

Locate well correctly on above
Section Plat

If a producing well is abandoned, date of last production 19
Was permission obtained from the Conservation Division or its agents before plugging was com-
menced? Yes
Name of Conservation Agent who supervised plugging of this well Mr. W. H. Kerr, Great Bend, Kansas
Producing formation Depth to top Bottom Total Depth of Well 3343 Feet
Show depth and thickness of all water, oil and gas formations.

OIL, GAS OR WATER RECORDS

CASING RECORD

Formation	Content	From	To	Size	Put In	Pulled Out
				10 3/4	80	None

Describe in detail the manner in which the well was plugged, indicating where the mud fluid was placed and the method or methods used in introducing it into the hold. If cement or other plugs were used, state the character of same and depth placed, from _____ feet to _____ feet for each plug set.

Jetted pits - Circulated thirty minutes - Layed down 1700' drill pipe - Filled hole with heavy mud - Layed down rest of drill pipe - Filled hole with heavy mud to 80 feet - Placed wood plug at 80 feet - Run 15 sax cement on this plug - Filled hole to 20 feet - Placed second wood plug - Filled hole with cement to 4 feet of surface.

18 9 16W
41 11

1/28/46
100-28-125

(If additional description is necessary, use BACK of this sheet)

Correspondence regarding this well should be addressed to Donald T. Ingling
Address 708 Fourth Nat'l Bank Bldg., Wichita 2, Kansas

STATE OF Kansas COUNTY OF Sedgwick, ss.
I - W. W. Wright (employee of owner) or (owner or operator) of the above-described well,
being first duly sworn on oath, says: That I have knowledge of the facts, statements, and matters herein contained and the log of the above-described well as filed and that the same are true and correct. So help me God.

(Signature) *W. W. Wright*

708 Fourth Nat'l Bank Bldg., Wichita 2, Ks.
(Address)

SUBSCRIBED AND SWORN to before me this 18th day of January, 1946

Leah V. Landrus
Notary Public.

My commission expires April 10, 1948

15-163-02933-00-00

WELL LOG COLAHAN NO. 2

Ingling & Bachus - Lease Owners

Sec. 18, Twp. 9, Range 16

Donald T. Ingling - Contractor

Location: C W/2 NW NW

Total Depth: 3343'

County: Rooks (Kansas)

Commenced: December 19, 1945

Elevation: 1998'

Completed: January 16, 1946

Casing: 80' of 10 3/4"

Production:

Figures below indicate bottom of formation:

525	Shale	2320	Lime
840	Shale & Shells	2355	Lime & Shale
935	Sand, Shale & Shells	2475	Lime
1010	Sand & Shale	2940	Lime & Shale
1200	Shale & Shells & Red Bed	3330	Lime
1235	Red Bed & Shale	3335	Lime & Shale
1265	Anhydrite	3340	Shale
1690	Shale & Shells	3343	Lime
1750	Shale, Lime & Gyp.	<u>3343</u>	<u>TOTAL DEPTH</u>
2040	Lime & Shale		
2125	Lime - broken (Cherty streaks)		
2140	Lime & Shale		
2205	Lime - broken		
2270	Lime & Shale		

I hereby certify that this is a true and correct log of the abovementioned well.

DONALD T. INGLING

JAN 28 1946
1/28/46

[Handwritten Signature]

18 9 16W
41 11

STATE OF KANSAS
: SS.
SEDGWICK COUNTY

Subscribed and sworn to before me, a Notary Public in said County and State this 18th day of January, 1946.

[Handwritten Signature]
Notary Public

My Commission expires: 4/10/48