

WELL PLUGGING RECORD

Give All Information Completely  
 Make Required Affidavit

COUNTY Rooks SEC. 18 TWP. 9 RGE. 16 E/W  
 Location as in quarters or footage from lines:  
SE SE NW/4


Locate Well  
 correctly on above  
 Section Platt.

Lease Owner Harold Krueger Co.  
 Lease Name Colahan Well No. 1 A *KCC ZAP*  
 Office Address Box 247, Natoma, Kansas 67651  
 Character of Well (Completed as Oil Gas or Dry Hole):  
 Date Well Completed 2-24-1963  
 Application for plugging filed 1-12-83  
 Plugging commenced 1-26-83 9:30 A.M.  
 Plugging completed 1-26-83 11:30 A.M.  
 Reason for abandonment of well or producing formation  
No production *KCC ZAP*  
 Was permission obtained from the Conservation Division or it's  
 Agent's before plugging was commenced? yes

Name of Conservation Agent who supervised plugging of this well Marion Schmidt  
 Producing formation KC Lime Depth to top 3147 bottom 3373 T.D. 3445  
 Show depth and thickness of all water, oil and gas formations.

OIL, GAS OR WATER RECORDS

Casing Record

Formation	Content	From	To	Size	Put in	Pulled Out
KC LIME	Oil	3147	3373	5 1/2	3441	None

Describe in detail the manner in which the well was plugged, indicating where the mud fluid was placed and the method or methods used in introducing it into the hold. If cement or other plugs were used, state the character of same and depth placed, from    feet to    feet for each plug set.

Pumped 90 sks cement and 2 sks. hulls down annulus. Pumped 100 sks. cement, 17 sks. gel and 3 sks. hulls down 5 1/2 casing.

STATE CORPORATION COMMISSION

JAN 27 1983

CONSERVATION DIVISION  
 Wichita, Kansas

(If additional description is necessary, use BACK of this sheet)

Name of Plugging Contractor Halliburton, Hays, Kansas

STATE OF KANSAS COUNTY OF OSBORNE, ss.

Dean Wineland

(employee of owner) or ~~(owner or operator)~~


above-described well, being first duly sworn on oath, says: That I have knowledge of the facts, statements, and matters herein contained and the log of the above-described well as filed and that the same are true and correct. So help me God.

(Signature) Dean Wineland  
Natoma, Kansas 67651  
 (Address)

SUBSCRIBED AND SWORN TO before me this 26<sup>th</sup> day of January, 19 83

Della M. Richmond  
 Notary Public.

My Commission expires: 7-12-84

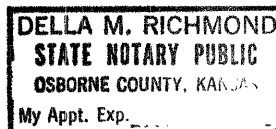

KCC/KDHE JOINT OIL/GAS REGULATORY OFFICE

FIELD REPORT

[ ] New Situation  
[ ] Response to Request  
[x] Follow-up

DATE 2-25-83

OPERATOR Harold Krueger Co. #5769

LOCATION SESE NW, Sec 18, T 9 S, R 16 W

NAME Harold Krueger Co.

LEASE Colohan Well # 1

& ADDRESS Box 247, Natoma, Kansas 67651 COUNTY Booke

PROBLEM: Cement had settled in well.

REASON FOR INVESTIGATION: Original cement plug that was squeezed in hole dropped.

PERSON(S) CONTACTED: \_\_\_\_\_

FINDINGS: Put a yard and half of cement in well to bring it up from 249 ft to top of surface pipe. Filled annulus and casing. Cement was done by Allied Beach mix Hays.

RECEIVED  
STATE CORPORATION COMMISSION

MAR 2 1983


CONSERVATION DIVISION  
Wichita, Kansas

3/2/83

ACTION/RECOMMENDATIONS: \_\_\_\_\_

Retain 1 copy Joint District Office  
Send 1 copy Conservation Division  
Send 1 copy KDHE/Topeka if appropriate

BY Ken Mowry

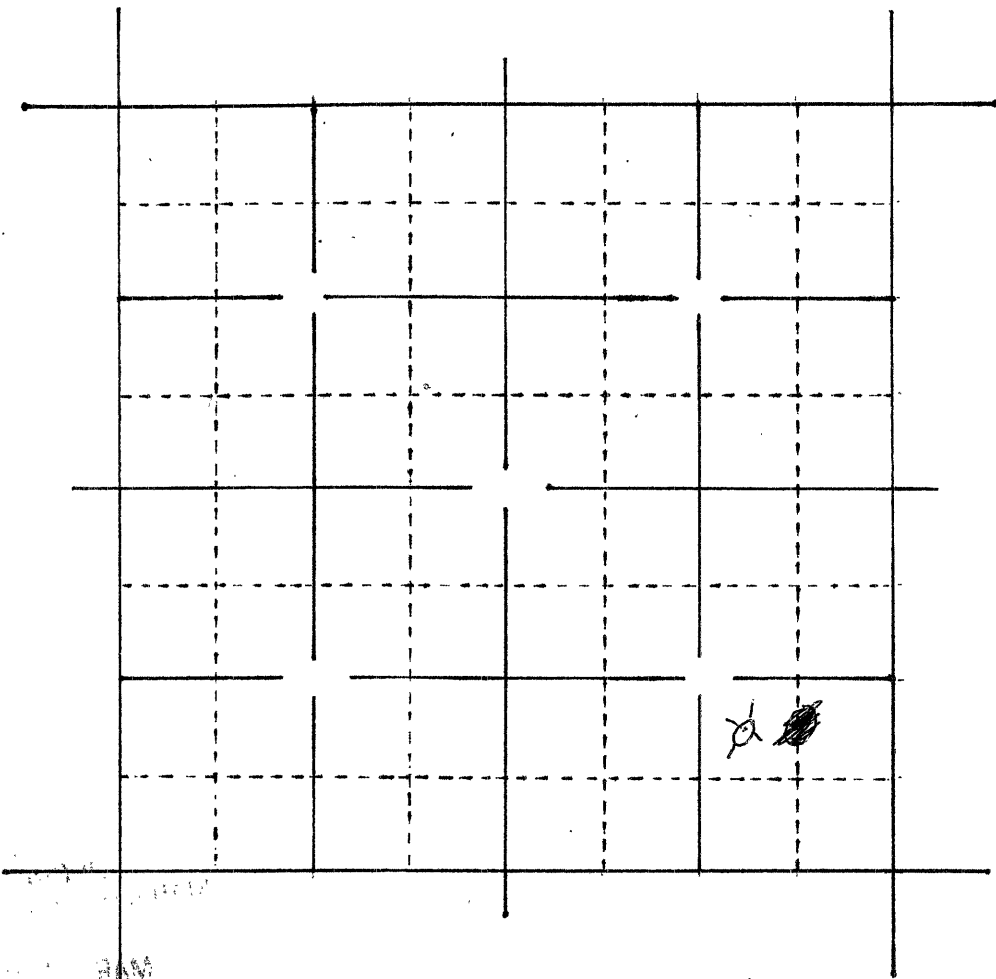

