


STATE OF KANSAS
STATE CORPORATION COMMISSION

15-163-00468-00-00

Give All Information Completely
Make Required Affidavit
Mail or Deliver Report to:
Conservation Division
State Corporation Commission
211 No. Broadway
Wichita, Kansas

WELL PLUGGING RECORD

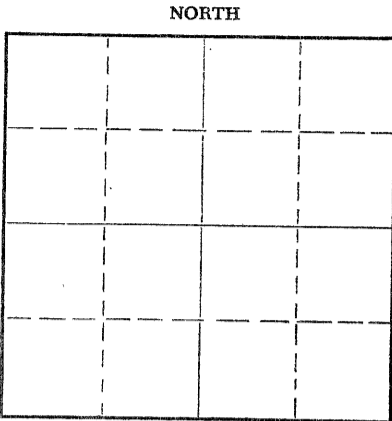

Locate well correctly on above Section Plat

Rooks County County. Sec. 1 Twp. 2S Rge. 17W (E) (W) X

Location as "NE/CNW/SW" or footage from lines NE NE NW

Lease Owner Burch Drilling

Lease Name Hrabe Well No. 1

Office Address 1011 Union Center, Wichita, Kansas

Character of Well (completed as Oil, Gas or Dry Hole) Dry Hole

Date well completed 8-15-58 19

Application for plugging filed 8-15-58 19

Application for plugging approved 8-15-58 19

Plugging commenced 8-15-58 19

Plugging completed 8-15-58 19

Reason for abandonment of well or producing formation Dry

If a producing well is abandoned, date of last production _____ 19

Was permission obtained from the Conservation Division or its agents before plugging was commenced? yes

Name of Conservation Agent who supervised plugging of this well Eldon Petty

Producing formation _____ Depth to top _____ Bottom _____ Total Depth of Well _____ Feet

Show depth and thickness of all water, oil and gas formations.

OIL, GAS OR WATER RECORDS

CASING RECORD

FORMATION	CONTENT	FROM	TO	SIZE	PUT IN	PULLED OUT
				8 5/8"	185'	none

Describe in detail the manner in which the well was plugged, indicating where the mud fluid was placed and the method or methods used in introducing it into the hole. If cement or other plugs were used, state the character of same and depth placed, from _____ feet to _____ feet for each plug set.

Set 1st Plug @ 600' with 20 sx.

Set 2nd Plug @ 180' with 15 sx.

Set 3rd Plug @ 40' with 10 sx.

(If additional description is necessary, use BACK of this sheet)

Name of Plugging Contractor Burch Drilling Co., Inc.

Address 1011 Union Center, Wichita, Kansas

STATE OF KANSAS, COUNTY OF SEDGWICK, ss.

Earl M. Burch (employee of owner) or (owner or operator) of the above-described

well, being first duly sworn on oath, says: That I have knowledge of the facts, statements, and matters herein contained and the log of the above-described well as filed and that the same are true and correct. So help me God.

(Signature) Earl M. Burch

(Address) _____, 19 58

SUBSCRIBED AND SWORN TO before me this 25th day of August

Henry Harrison 8/26/58
Notary Public.

My commission expires July 27, 1960

PLUGGING
FILE SEC 1 T 9 R 17
BOOK PAGE 124 LINE 14

15-163-00468-00-00

WELL LOG

Burch Drilling Co., Inc.
1 Hrabe
NE NE NW, 1-9S-17W
Rooks County, Kansas

8/58" set at 185' w/150 sx.
ELEVATION: 1981' Kelly Bushing
COMM: 8-7-58
COMP: 8-15-58
D & A

100 Shale
1270 Shale & Shells
1272 Shale
1318 Anhydrite
1904 Shale & Lime Streaks
3135 Lime & Shale
3366 Lime
3481 Cherty Lime

3481 RTD

TOPS
HEEBNER 3092'
TORONTO 3111'
LANSING 3136'
BKC 3378'
CONGLOMERATE 3444'

DST # 1 3124-3150 Open 1 hr.
Recovered 6' Mud. All pressures 0#.

DST # 2 3156-3195 Open 1 hr.
Recovered 12' Mud All pressures 0#.

DST # 3 3200-3245 Open 1 hr.
Recovered 50' Mud with few specks
oil in tool. IBHP (30Min) 810#.
IFP 0, FFP 0#, FBHP (30Min) 680#.

DST # 4 3288-3317 Open 1 hrs.
Recovered 11' Mud. IBHP (30Min)
1150#, IFP 0, FFP 0, FBHP (30Min) 75#.

STATE OF KANSAS, COUNTY OF SEDGWICK:

I, Earl M. Burch, President of Burch Drilling Co., Inc. being duly sworn on oath,
state: That I have knowledge of the facts, statements and matters herein contained and
that the same are true and correct.

Earl M. Burch

Subscribed and sworn to before me this 25th day of August, 1958.

Geney Harrison
Notary Public

My Commission expires: July 27, 1960.

8/26/58

PLUGGING
FILE SEC 1 T 9 R 17W
BOOK PAGE 124 LINE 14