


Give All Information Completely
Make Required Affidavit
Mail or Deliver Report to:
Conservation Division
State Corporation Commission
212 No. Market
Wichita, Kansas

WELL PLUGGING RECORD

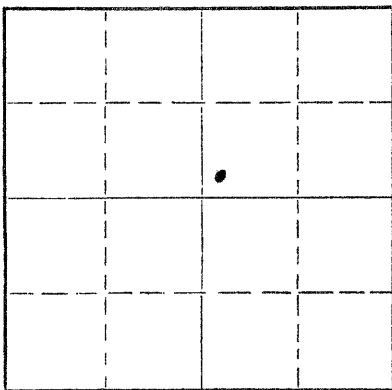

Location as "NE/CNW*SW*" or footage from lines Book 6 County, Sec. 1 Twp. 9S Rge. 19W (E) (W)
SW NENE
Lease Owner George P. Crawford
Lease Name Wm. H. Hrabec William Hrabec ^{KIC} ²¹⁴⁶ Well No. 1
Office Address Box 93 Natoma, Kansas
Character of Well (completed as Oil, Gas or Dry Hole) Dry Hole
Date well completed _____ 19 66
Application for plugging filed _____ 19 66
Application for plugging approved _____ 19 66
Plugging commenced 3-27-66 19 66
Plugging completed 3-27-66 19 66
Reason for abandonment of well or producing formation wash down out of Hole.
If a producing well is abandoned, date of last production _____ 19 _____
Was permission obtained from the Conservation Division or its agents before plugging was commenced? yes

Name of Conservation Agent who supervised plugging of this well Mr. Leo Massey
Producing formation _____ Depth to top _____ Bottom _____ Total Depth of Well 1245 Feet
Show depth and thickness of all water, oil and gas formations.

OIL, GAS OR WATER RECORDS

CASING RECORD

FORMATION	CONTENT	FROM	TO	PULLED OUT

RECEIVED
APR 19 1966
4/19/66
CONSERVATION DIVISION
WICHITA, KANSAS

Describe in detail the manner in which the well was plugged, indicating where the mud fluid was placed and the method or methods used in introducing it into the hole. If cement or other plugs were used, state the character of same and depth placed, from _____ feet to _____ feet for each plug set.

well was started to wash out 3-22-66
drilled down + went out of hole, drilled to 1245'
could not get in hole plugged well 3-27-66 8 AM,
Leo Massey from Hays Kansas set on well
plug set at 540' 12 sacks cement used.
plug set at 200' 20 sacks cement used.
solid bridge plug set at 40' 10 sack cement used.
well was full of mud all the way.
mud circulated out as cement was put on plugs.

(If additional description is necessary, use BACK of this sheet)
Name of Plugging Contractor Baseneraty - Bemis Drilling Co
Address Box 713 Great Bend, Kansas

STATE OF Kansas, COUNTY OF Osborne, ss.
George P Crawford (employee of owner) or (owner or operator) of the above-described well, being first duly sworn on oath, says: That I have knowledge of the facts, statements, and matters herein contained and the log of the above-described well as filed and that the same are true and correct. So help me God.

(Signature) George P Crawford
Natoma, Kansas (Address)

SUBSCRIBED AND SWORN TO before me this 26 day of April 19 66

My commission expires February 17, 1967
Inez Schloh Notary Public.