


**STATE OF KANSAS**  
**STATE CORPORATION COMMISSION**

**Give All Information Completely**  
**Make Required Affidavit**  
**Mail or Deliver Report to:**  
**Conservation Division**  
**State Corporation Commission**  
**800 Bitting Building**  
**Wichita, Kansas**

NORTH

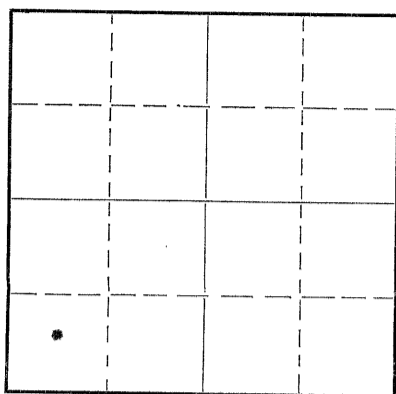

**Locate well correctly on above  
Section Plat**

## WELL PLUGGING RECORD

Books \_\_\_\_\_ County. Sec. 1 Twp. 9 Rge. \_\_\_\_\_ (E) 17 (W)  
 Location as "NE/CNW $\frac{1}{4}$ SW $\frac{1}{4}$ " or footage from lines \_\_\_\_\_  
 Lease Owner Plain-Stock Oil & Gas Co.  
 Lease Name William Hrabec Well No. 1  
 Office Address Plainville, Kansas  
 Character of Well (completed as Oil, Gas or Dry Hole) Wash Over  
 Date well completed May 23, 1959 19\_\_\_\_  
 Application for plugging filed May 22, 1959, by phone 19\_\_\_\_  
 Application for plugging approved May 22, 1959 19\_\_\_\_  
 Plugging commenced May 23, 1959 19\_\_\_\_  
 Plugging completed May 23, 1959 19\_\_\_\_  
 Reason for abandonment of well or producing formation Tools started new hole  
at 460  
 If a producing well is abandoned, date of last production \_\_\_\_\_ 19\_\_\_\_  
 Was permission obtained from the Conservation Division or its agents before plugging was com-  
 menced? Yes

Name of Conservation Agent who supervised plugging of this well Eldon Petty  
Producing formation..... Depth to top..... Bottom..... Total Depth of Well 550 Feet  
Show depth and thickness of all water, oil and gas formations.

## OIL, GAS OR WATER RECORDS

### CASING RECORD

[illegible]

Describe in detail the manner in which the well was plugged, indicating where the mud fluid was placed and the method or methods used in introducing it into the hole. If cement or other plugs were used, state the character of same and depth placed, from.....feet to .....feet for each plug set.

Plug set 550': 20 sacks cement,  
filled hole with mud to 150'  
Set plug 150': 20 sacks cement,  
filled hole to 35': 10 sacks cement.

RECEIVED  
STATE CORPORATION COMMISSION  
1959

AUG 7 1959

CONSERVATION DIVISION  
Wichita, Kansas

8/7/54

(If additional description is necessary, use BACK of this sheet)

Correspondence regarding this well should be addressed to Plain-Stock Oil & Gas Co.  
Address Plainville, Kansas.

STATE OF KANSAS, COUNTY OF ROCK ss.

being first duly sworn on oath, says: That I have knowledge of the facts, statements, and matters herein contained and the log of the above-described well as filed and that the same are true and correct. So help me God.

(Signature)

Plainville, Kansas.  
(Address)

SUBSCRIBED AND SWORN to before me this 6th day of August, 1950

My commission expires.

22-5133-S

9-48—10M

PLUGGING  
FILE SEC 1 T 9 R 17W  
BOOK PAGE 57 LINE 5