

STATE OF KANSAS
STATE CORPORATION COMMISSION


15-163-19219-00-00
WELL PLUGGING RECORD

Give All Information Completely
Make Required Affidavit
Mail or Deliver Report to:
Conservation Division
State Corporation Commission
800 Bitting Building
Wichita, Kansas

Rooks County, Sec. 21 Twp. 9 Rge. 16 (E) (W)

Location as "NE/CNW/SW" or footage from lines SW 21 NE Ne
Lease Owner Harry Gore, et al
Lease Name Casey Well No. 3
Office Address 400 Brown Building, Wichita, Kansas
Character of Well (completed as Oil, Gas or Dry Hole) Dry Hole
Date well completed 12-20 19 54
Application for plugging filed 12-20 19 54
Application for plugging approved 12-20 19 54
Plugging commenced 12-20 19 54
Plugging completed 12-20 19 54
Reason for abandonment of well or producing formation Dry Hole

NORTH

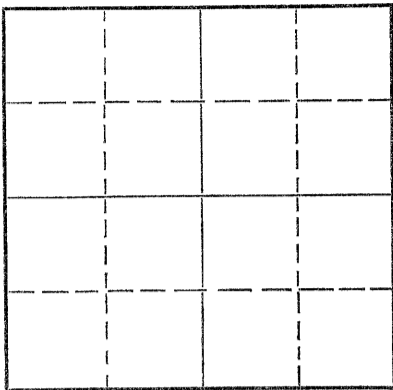

Locate well correctly on above Section Plat

If a producing well is abandoned, date of last production _____ 19____
Was permission obtained from the Conservation Division or its agents before plugging was commenced? Yes

Name of Conservation Agent who supervised plugging of this well Eldon Petty, Hays, Kansas
Producing formation _____ Depth to top _____ Bottom _____ Total Depth of Well 3416 Feet
Show depth and thickness of all water, oil and gas formations.

OIL, GAS OR WATER RECORDS

CASING RECORD

| FORMATION | CONTENT | FROM | TO | SIZE | PUT IN | PULLED OUT |
|-----------|---------|------|----|--------|--------|------------|
| | | | | 8 5/8" | 155' | |
| | | | | | | |
| | | | | | | |
| | | | | | | |
| | | | | | | |
| | | | | | | |
| | | | | | | |
| | | | | | | |
| | | | | | | |

Describe in detail the manner in which the well was plugged, indicating where the mud fluid was placed and the method or methods used in introducing it into the hole. If cement or other plugs were used, state the character of same and depth placed, from _____ feet to _____ feet for each plug set.

Mud from 3416' to 150', plug set at 150' and 1/2 sack hulls, 15 sacks cement
150' to 105'; mud 105' to 40', plug at 40', 12 sack hulls, 10 sacks cement,
40' to base cellar.

(If additional description is necessary, use BACK of this sheet)

Name of Plugging Contractor Veeder Supply and Development Co.
Address P. O. Box 201, Cherryvale, Kansas

12/30/54

STATE OF Kansas, COUNTY OF Montgomery, ss.
Floyd W. Hild (employee of owner) or (owner or operator) of the above-described well, being first duly sworn on oath, says: That I have knowledge of the facts, statements, and matters herein contained and the log of the above-described well as filed and that the same are true and correct. So help me God.

(Signature) Floyd W. Hild
Cherryvale, Kansas
(Address)

SUBSCRIBED AND SWORN TO before me this 23rd day of December, 19 54

My commission expires July 11, 1956

Oliver Lawson
Notary Public.

24-7368-S 3-53-20M

PLUGGING
FILE SEC 21 T 9 R 16W
BOOK PAGE 87 LINE 6

15-163-19219-00-00

Veeder Supply & Dev'l. Co.



Cherryvale, Kansas

Drilled for Harry Gore-Veeder supply & Dev'l. Co. Farm Cassy No. 2 Depth 3116
 Contractor Veeder Supply & Development Co. Pipe 155' 8 5/8" casg. cemented w/85 sacks cement
 Location SW NENE Sec. 21 Twp. 9 Range 16
 Commenced 12-10-1954 Completed 12-20-1954 County Rooks State Kansas

| | | | | | |
|------------------------|------|------|-----|--------------|------|
| Soil, sand, chalk | 0 | 30 | 30 | <u>TOPS:</u> | |
| Yellow shale and chalk | 30 | 125 | 95 | | |
| Blue shale | 125 | 155 | 30 | Topoka | 2943 |
| Shale | 155 | 730 | 575 | Rechner | 3171 |
| Sand | 730 | 820 | 90 | Toronto | 3192 |
| Shale | 820 | 900 | 80 | Lansing | 3211 |
| Shale and red bed | 900 | 1312 | 412 | | |
| Anhydrite | 1312 | 1355 | 43 | | |
| Shale and shells | 1355 | 1725 | 370 | | |
| Shale | 1725 | 1975 | 250 | | |
| Lime, shells and shale | 1975 | 2120 | 145 | | |
| Lime | 2120 | 2230 | 110 | | |
| Lime and shale | 2230 | 3010 | 780 | | |
| Lime | 3010 | 3120 | 110 | | |
| Lime and shale | 3120 | 3180 | 60 | | |
| Lime | 3180 | 3335 | 155 | | |
| Lime and chert | 3335 | 3363 | 28 | | |
| Lime | 3363 | 3416 | 53 | | |
| Total Depth | | | | | |

Dry and abandoned

AFFIDAVIT

STATE OF KANSAS }
Montgomery County } SS

Floyd W. Hill, of lawful age, being first duly sworn on oath, deposes and says:

THAT he is a resident of Cherryvale, Montgomery County, Kansas; that he knows and hereby on oath states that the above and foregoing drilling log covering the Cassy #2 well located in Sec. 21-9-16, Rooks County, Kansas, is true and correct. Further affiant saith not.

THE VEEDER SUPPLY AND DEVELOPMENT CO.
BY Floyd W. Hill
Floyd W. Hill

Subscribed and sworn to before me this 23rd day of December, 1954.

Oliver Lawson
Notary Public

My commission expires July 11, 1956.

PLUGGING
WELL SEC 21 T 9 R 16 W
BOOK PAGE 87 LINE 6