


STATE OF KANSAS
STATE CORPORATION COMMISSION

Give All Information Completely
Make Required Affidavit
Mail or Deliver Report to:
Conservation Division
State Corporation Commission
800 Bittling Building
Wichita, Kansas

15-103-00593-00-00

WELL PLUGGING RECORD

NORTH

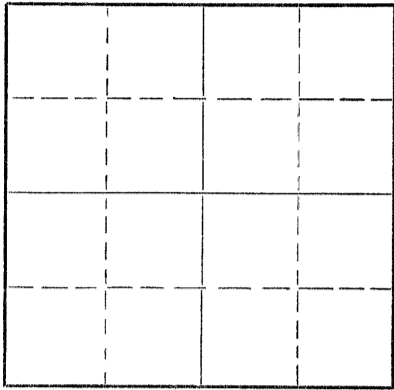

Locate well correctly on above
Section Plat

Rooks

County, Sec. 22 Twp. 9 Rge. (E) 16 (W)

Location as "NE/CNW $\frac{1}{4}$ SW $\frac{1}{4}$ " or footage from lines SW/4 SW/4 SW/4

Lease Owner J. H. Johnson

Lease Name Casey

Well No. 1

Office Address Kansas City, Missouri

Character of Well (completed as Oil, Gas or Dry Hole) Dry Hole

Date well completed December 11 19 52

Application for plugging filed December 11 19 52

Application for plugging approved December 11 19 52

Plugging commenced December 11 19 52

Plugging completed December 11 19 52

Reason for abandonment of well or producing formation Dry Hole

If a producing well is abandoned, date of last production _____ 19 _____

Was permission obtained from the Conservation Division or its agents before plugging was commenced? Yes

Name of Conservation Agent who supervised plugging of this well E. R. Petty, Hays, Kansas

Producing formation _____ Depth to top _____ Bottom _____ Total Depth of Well 3611 Feet

Show depth and thickness of all water, oil and gas formations.

OIL, GAS OR WATER RECORDS

CASING RECORD

FORMATION	CONTENT	FROM	TO	SIZE	PUT IN	PULLED OUT
				8 5/8	222.25	None
				(Circulated Top to Bottom)		

Describe in detail the manner in which the well was plugged, indicating where the mud fluid was placed and the method or methods used in introducing it into the hole. If cement or other plugs were used, state the character of same and depth placed, from 3611 feet to 0 feet for each plug set.

Filled Hole With Heavy Mud to 210'.
Placed 1/2 Sack Hulls in Hole.
Set a Bridging Plug.
Placed 1/2 Sack Hulls On Top of Plug.
Placed 35 Sacks Cement on Top of Hulls.
Filled Hole With Heavy Mud to 35'.
Placed 1/2 Sack Hulls in Hole.
Set a Bridging Plug.
Placed 1/2 Sack Hulls on Top of Plug.
Placed 10 Sacks Cement on Top of Hulls to Top of Hole.

(If additional description is necessary, use BACK of this sheet)

Name of Plugging Contractor Stearns Drilling Company

Address Russell, Kansas

STATE OF KANSAS, COUNTY OF RUSSELL, ss.
O. G. Stearns (employee of owner) or (owner or operator) of the above-described

well, being first duly sworn on oath, says: That I have knowledge of the facts, statements, and matters herein contained and the log of the above-described well as filed and that the same are true and correct. So help me God

(Signature) [Signature]

Russell, Kansas

(Address)

SUBSCRIBED AND SWORN TO before me this 12th day of December, 19 52

[Signature]

Notary Public.

My commission expires June 20, 1953.

24-2675-S 2-52-20M

PLUGGING
FILE SEC 22 T 9 R 16
BOOK PAGE 66 LINE 1

RECEIVED
DEC 15 1952
CONSERVATION DIVISION

15-163-00593-00-00

CASEY #1

Operator: J. H. Johnson
Contractor: Stearns Drilling Company
Commencement Date: November 19, 1952
Completion Date: December 11, 1952

Location: SW/4 SW/4 SW/4
Sec. 22-9-16
Rooks Co., Kansas

Casing Record:

8 5/8" 222.25' Cemented With 100 Sacks.

WELL LOG

Surface Clay	0	40
Sand and Shale	40	150
Shale	150	280
Shale and Shells	280	720
Sand	720	765
Shale and Shells	765	850
Sand	850	960
Red Bed and Shale	960	1260
Anhydrite	1260	1290
Shale	1290	1430
Shale and Shells	1430	1850
Lime and Shale	1850	1990
Shale and Shells	1990	2190
Lime and Shale	2190	2245
Shale and Shells	2245	2300
Lime and Shale	2300	2520
Shale and Shells	2520	2596
Lime and Shale	2596	3106
Shale	3106	3115
Lime and Shale	3115	3185
Lime	3185	3443
Lime and Shale	3443	3510
Conglomerate	3510	3535
Shale and Lime	3535	3602
Lime	3602	3611
Total Depth	3611	

STATE OF KANSAS)
) SS:
COUNTY OF RUSSELL)

I hereby certify that the above is true and correct to the best of my knowledge and belief.

J. H. Stearns

SUBSCRIBED and sworn to before me this 12th -day of December, 1952.

Harold Arborek
Notary Public

My Commission Expires: June 20, 1953.

PLUGGING
FILE SEC 22 T 9 R 16 34
BOOK PAGE 66 LINE 1

12-15-52