


STATE OF KANSAS  
STATE CORPORATION COMMISSION

WELL PLUGGING RECORD

Give All Information Completely  
Make Required Affidavit  
Mail or Deliver Report to  
Conservation Division  
State Corporation Comm.,  
245 North Water  
Wichita, KS 67202

Rooks County, Sec. 23 Twp. 9S Rge. 16 NE/W  
Location as "NE/CNW $\frac{1}{4}$ SW $\frac{1}{4}$ " or footage from lines  
NW SE NW

Lease Owner Abraxas Petroleum Corporation  
Lease Name Haller Well No. #1  
Office Address P. O. Box 17485, San Antonio, Texas 78217  
Character of Well (Completed as Oil, Gas or Dry Hole) Dry Hole

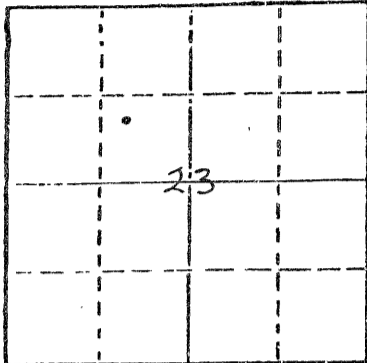

Locate well correctly on above Section Plat

Date Well completed 10-2-80 19  
Application for plugging filed 10-1-80 19  
Application for plugging approved 10-1-80 19  
Plugging commenced 10-1-80 19  
Plugging completed 10-2-80 19  
Reason for abandonment of well or producing formation  
Commercial quantities of oil not found  
If a producing well is abandoned, date of last production 19

Was permission obtained from the Conservation Division or its agents before plugging was commenced? Yes

Name of Conservation Agent who supervised plugging of this well Marion Schmidt  
Producing formation \_\_\_\_\_ Depth to top \_\_\_\_\_ Bottom \_\_\_\_\_ Total Depth of Well 3530'  
Show depth and thickness of all water, oil and gas formations.

OIL, GAS OR WATER RECORDS

CASING RECORD

FORMATION	CONTENT	FROM	TO	SIZE	PUT IN	PULLED OUT
				8 5/8"	215'	None

Describe in detail the manner in which the well was plugged, indicating where the mud fluid was placed and the method or methods used in introducing it into the hold. If cement or other plugs were used, state the character of same and depth placed, from \_\_\_\_\_ feet to \_\_\_\_\_ feet for each plug set.

Plug @ 730' w/70 sx.  
Plug @ 180' w/25 sx.  
Plug @ 40' w/10 sx.  
Rat Hole 5 sx.

RECEIVED  
STATE CORPORATION COMMISSION  
OCT 30 1980  
CONSERVATION DIVISION  
Wichita, Kansas

(If additional description is necessary, use BACK of this sheet)

Name of Plugging Contractor Rains & Williamson Oil Co., Inc.

STATE OF Kansas COUNTY OF Sedgwick, ss. 10-20-80  
Wilson Rains, President of Rains & Williamson Oil Co., Inc. (employee of owner) or (owner or operator) of the above-described well, being first duly sworn on oath, says: That I have knowledge of the facts, statements, and matters herein contained and the log of the above-described well as filed and that the same are true and correct. So help me God.

(Signature) Wilson Rains  
435 Page Court, 220 W. Douglas, Wichita, Kans. 67202  
(Address)

SUBSCRIBED AND SWORN TO before me this 7 day of October, 19 80

My commission expires \_\_\_\_\_

10-4-83

Juanita M. Green  
Juanita M. Green Notary Public.



DRILLER'S LOG

15-163-21044-00-00

COMPANY: Abraxas Petroleum Corporation

SEC. 23 T. 9S R. 16W

WELL NAME: Haller #1

LOC. NW SE NW

RIG NO. #4

COUNTY: Rooks

TOTAL DEPTH 3530'

ELEVATION: 1,978' Gr.  
1,985' KB

COMMENCED: 9-22-80

COMPLETED: 10-2-80

CONTRACTOR: Rains & Williamson Oil Co., Inc.

CASING RECORD:

SURFACE: 8 5/8" @ 215' w/150 sx. common, 2% gel, 3% cc.

PRODUCTION: D&A

LOG

(Figures Indicate Bottom of Formations)

Clay, Sand & Shale	217
Shale	2105
Shale & Lime	2195
Shale	2295
Shale & Lime	2530
Lime & Shale	2730
Shale & Lime	2980.
Lime & Shale	3200
Lime	3530
<u>ROTARY TOTAL DEPTH</u>	<u>3530</u>

STATE OF Kansas)

COUNTY OF Sedgwick)

SS:

I, Wilson Rains, President of Rains & Williamson Oil Co., Inc.

upon oath state that the above and foregoing is a true and correct copy of the log of the

Haller #1 well.

*Wilson Rains*

Wilson Rains

Subscribed and sworn to before me this 7 day of October, 1980.

My Appointment Expires:

10-4-83

*Juanita M. Green*

Juanita M. Green

STATE CORPORATION COMMISSION  
RECEIVED  
OCT 20 1980  
CONSERVATION DIVISION  
Wichita, Kansas

16-20-80

