


Give All Information Completely
Make Required Affidavit
Mail or Deliver Report to:
Conservation Division
State Corporation Commission
800 Biting Building
Wichita, Kansas

15-163-19040-00-00

WELL PLUGGING RECORD

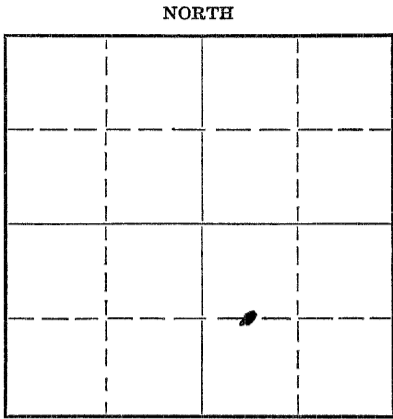

Locate well correctly on above
Section Plat

Rooks _____ County. Sec. 1 Twp. 9 Rge. 17 (E) W (W)
Location as "NE/CNW $\frac{1}{4}$ SW $\frac{1}{4}$ " or footage from lines CW $\frac{1}{2}$ W $\frac{1}{2}$ SE
Lease Owner Fred E. Cook
Lease Name Hraba Well No. 1
Office Address 3023 South Erie
Character of Well (completed as Oil, Gas or Dry Hole) dry hole
Date well completed December 29 19 52
Application for plugging filed December 29 19 52
Application for plugging approved December 29 19 52
Plugging commenced December 29 19 52
Plugging completed December 29 19 52
Reason for abandonment of well or producing formation _____

If a producing well is abandoned, date of last production _____ 19 _____
Was permission obtained from the Conservation Division or its agents before plugging was commenced? yes

Name of Conservation Agent who supervised plugging of this well ELDON PERRY
Producing formation _____ Depth to top _____ Bottom _____ Total Depth of Well 3429 Feet
Show depth and thickness of all water, oil and gas formations.

OIL, GAS OR WATER RECORDS

CASING RECORD

Formation	Content	From	To	Size	Put In	Pulled Out
surface pipe		0	199	8.5/8"	199	None

Describe in detail the manner in which the well was plugged, indicating where the mud fluid was placed and the method or methods used in introducing it into the hole. If cement or other plugs were used, state the character of same and depth placed, from _____ feet to _____ feet for each plug set.

Filled hole to 180' with mud. Pushed bottom plug to 180'. Mixed and ran 15 sacks cement. Filled to 40' with mud. Pushed top plug to 40'. Put $\frac{1}{2}$ sack hulls on top of plug. Mixed 10 sacks cement. Filled to bottom of cellar.

(If additional description is necessary, use BACK of this sheet)

Name of Plugging Contractor Bill Hay Drilling Company
Address Box 194, Great Bend, Kansas

STATE OF Kansas, COUNTY OF Barton, ss.
Virgil E. Belford, Jr. (employee of owner) or (~~owner or operator~~) of the above-described well, being first duly sworn on oath, says: That I have knowledge of the facts, statements, and matters herein contained and the log of the above-described well as filed and that the same are true and correct. So help me God.

(Signature) Virgil E. Belford, Jr.
Box 194, Great Bend, Kansas (Address)

SUBSCRIBED AND SWORN to before me this 9th day of January, 19 53

My commission expires April 29, 1953

Dean C. Cooley
Notary Public.

JAN 1 1953
STATE CORPORATION COMMISSION
Wichita, Kansas
PLUGGING
11/10/53
PAGE 69 LINE 22

WELL LOG

Hrabe Well #1
 CW $\frac{1}{2}$ W $\frac{1}{2}$ SE 1-9-17W
 Rooks County, Kansas

0 - 193	Rock and Shale		
193 - 880	Shale and Shells		
880 - 1000	Sand		
1000 - 1185	Shale and Shells		
1185 - 1215	Pyrite		
1215 - 1235	Pyrite and Shells		
1235 - 1250	Shale and Pyrite		
1250 - 1275	Anhydrite		
1275 - 1700	Shale and Red Bed	Anhydrite	1200
1700 - 1850	Shale and Lime	Arbuckle	3407
1850 - 2200	Shale and Lime	T. D.	3429
2200 - 2515	Shale and Lime		
2515 - 2865	Shale and Lime		
2865 - 2985	Shale and Lime		
2985 - 3045	Lime		
3045 - 3150	Shale and Lime		
3150 - 3200	Lime		
3200 - 3225	Lime and Shale		
3225 - 3325	Lime		
3325 - 3389	Lime and Shale		
3389 - 3395	Lime and Shale		
3395 - 3407	Lime, Shale and Pyrite		
3407 - 3429	Arbuckle		
3429	T. D.		

STATE OF KANSAS)
 COUNTY OF BARTON) ss

Virgil E. Belford, Jr., Employee of owner of the above described well being first dully sworn on oath, says: that I have knowledge of the facts, statements, and matters herein contained and the log of the above-described well as filed and that the same are true and correct to the best of my knowledge and belief.

Virgil E. Belford Jr
 Box 194 GREAT Bend, KANSAS

Subscribed and Sworn to before me this 9th day of January, 1953

My Commission Expires April 29, 1953 Dean L. Cooley
 Notary Public

JAN 10 1953
 DIVISION
 KANSAS

PLUGGING
 REC REC L 7 9 17 W
 BOOK PAGE 69 LINE 22