


Give All Information Completely
Make Required Affidavit
Mail or Deliver Report to:
Conservation Division
State Corporation Commission
212 No. Market
Wichita, Kansas

WELL PLUGGING RECORD

NORTH

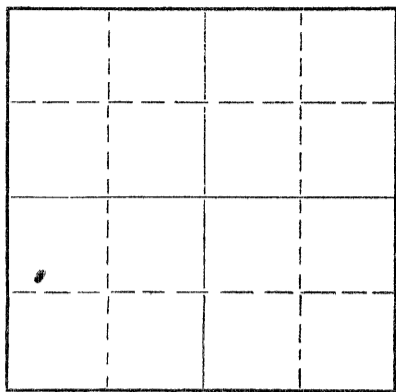

Locate well correctly on above
Section Plat

Rooks County, Sec. 1 Twp. 9 Rge. 17 (W)
Location as "NE/CNW/SW" or footage from lines SW-NW-SE.

Lease Owner George P. Crawford + Berkley Agency Inc,

Lease Name W.H. Nabel Well No. 3

Office Address Rt. 1 Box 93 Natoma, Kansas

Character of Well (completed as Oil, Gas or Dry Hole) _____

Date well completed 1-11-68 1968

Application for plugging filed 1-11 1968

Application for plugging approved 1-11 1968

Plugging commenced 1-11 1968

Plugging completed 1-11 1968

Reason for abandonment of well or producing formation Washdown Hole drilled 1275' + was out of hole.

If a producing well is abandoned, date of last production _____ 19____

Was permission obtained from the Conservation Division or its agents before plugging was commenced? State Plugging from Hays was called.

Name of Conservation Agent who supervised plugging of this well Leo Massey, Box 582 Hays Kans.

Producing formation _____ Depth to top _____ Bottom _____ Total Depth of Well 1275 Feet

Show depth and thickness of all water, oil and gas formations.

OIL, GAS OR WATER RECORDS

CASING RECORD

FORMATION	CONTENT	FROM	TO	SIZE	PUT IN	PULLED OUT

Describe in detail the manner in which the well was plugged, indicating where the mud fluid was placed and the method or methods used in introducing it into the hole. If cement or other plugs were used, state the character of same and depth placed, from _____ feet to _____ feet for each plug set.

540' 100 cft C
180' 25 cft C
40' 10 cft C
Cemented through drill pipe plug at

Cemented by Allied
Cementing Co. Inc. Russell, Kansas

RECEIVED
STATE CORPORATION COMMISSION
FEB 28 1968
CONSERVATION DIVISION
Wichita, Kansas

2/28/68

(If additional description is necessary, use BACK of this sheet)

Name of Plugging Contractor L. J. Dreiling & Sons, Inc.
Address Victoria, Kansas

STATE OF KANSAS, COUNTY OF ROOKS, ss.
George P. Crawford (employee of owner) or (owner or operator) of the above-described

well, being first duly sworn on oath, says: That I have knowledge of the facts, statements, and matters herein contained and the log of the above-described well as filed and that the same are true and correct. So help me God.

(Signature) George P. Crawford

SUBSCRIBED AND SWORN TO before me this 26th day of Feb, 1968

My commission expires Dec 19, 1968
Jack B. Berkley Notary Public.